

MISSISSIPPI DEPARTMENT OF NATURAL RESOURCES

Bureau of Land and Water Resources

Southport Mall

P.O. Box 10631

Jackson, Mississippi 39209

WATER WELL DRILLERS LOG

Newton
A
2024

2-26-82 19 McDonald & Hill Newton
date well completed firm name county well located

LANDOWNER:	description of formations encountered	from	to
<u>David Borends</u>	<u>clay & sand</u>	<u>0</u>	<u>35</u>
<u>Rt # 1 Conehatta</u> (mailing address)	<u>shale</u>	<u>35</u>	<u>45</u>
WELL LOCATION: sec. <u>34</u> T. <u>8</u> N. R. <u>11</u> E <u>5</u> miles <u>N</u> of <u>Conehatta</u> (distance) (direction) (nearest town)	<u>sandy shale</u>	<u>45</u>	<u>70</u>
	<u>clay & sand</u>	<u>70</u>	<u>85</u>
	<u>shale & sand</u>	<u>85</u>	<u>130</u>
WELL PURPOSE: <u>home</u> (home, irrigation, municipal, industrial)	<u>shale & lignite</u>	<u>130</u>	<u>160</u>
WELL COMPLETION DATA:	<u>shale & sand</u>	<u>160</u>	<u>185</u>
(1) diameter (inches) <u>4"</u>	<u>sand</u>	<u>185</u>	<u>235</u>
(2) total depth (feet) <u>380</u>	<u>sandy shale</u>	<u>235</u>	<u>270</u>
(3) static water level (feet) <u>160</u> below top of ground.	<u>shale</u>	<u>270</u>	<u>319</u>
(4) casing <u>pvc</u> <u>282'</u> (material) (depth)	<u>rock & shells</u>	<u>319</u>	<u>350</u>
<u>4"</u> if telescope see back. (size)	<u>green sand & sandy shale</u>	<u>350</u>	<u>370</u>
(5) screen _____ (length) (depth to top)	<u>rock & shale</u>	<u>370</u>	<u>380</u>
(size) _____ (material)			
(6) pump <u>3/4</u> <u>890 m</u> (HP) (yield gpm)			
<u>F</u> (type power)			
(7) electric log _____ (yes or no)			
(organization running log)			
(8) how well bottom plugged <u>Open</u>			
DRILLERS REMARKS:			


DEPT. OF NATURAL RESOURCES
BUREAU OF LAND & WATER RESOURCES

MAR - 2 1982

RECEIVED

If well telescopes please sketch and show depths.

GROUND LEVEL

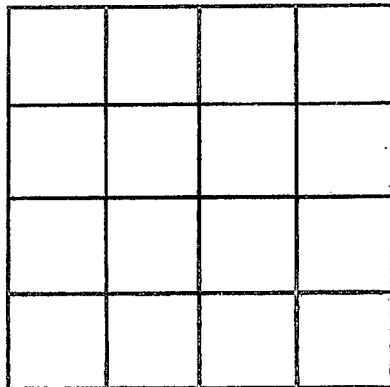

SECTION _____

Please indicate well location X.

ADDITIONAL INFORMATION

If more than one screen, show locations of each on sketch.