

Newton
A
2025

MISSISSIPPI
 BOARD OF WATER COMMISSIONERS
 416 North State Street
 Jackson, Mississippi 39201

4

WATER WELL DRILLERS LOG

3-26- 1982 Common Drilling Co. Newton
 date well completed firm name county well located

LANDOWNER: Bob Boylen
Rte #1 Cambridge, Miss
 (mailing address)

WELL LOCATION:
 sec 36 T 8 N R 10 E
S W
6 miles (distance) S. E. (direction) of Sebastopol (nearest town)

WELL PURPOSE: Home
 (home, irrigation, municipal, industrial)

- WELL COMPLETION DATA:
- diameter (inches) 2"
 - total depth (feet) 240'
 - static water level (feet) 75 below above top of ground.
 - casing DVC (material) 170' (depth)
 (size) If telescope see back.
 - screen None (length) (depth to top)
 (size) (material)
 - pump 1 (HP) (yield gpm)
 (type power)
 - electric log (yes or no)
 (organization running log)
 - how well bottom plugged


description of formations encountered	from	to
Clay	0	22
Sandy Clay	22	42
Sand and Clay ledges	42	82
Clay and sand	82	102
Clay and some sand	82	102
Ledges	102	128
Clay and some sand ledges	128	129
Hard Rock	129	144
Clay	144	174
Clay	174	184
Clay + Rock	184	201
SANDY Rock Ledges	201	225
SAND AND ROCK	225	240

DEPT. OF NATURAL RESOURCES
 BUREAU OF LAND & WATER RESOURCES
 JUL - 1 1982
 RECEIVED

DRILLERS REMARKS:

If well telescopes please sketch and show depths.

GROUND LEVEL

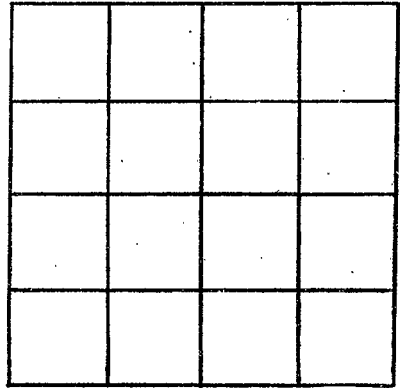

SECTION _____

Please indicate well location X.

ADDITIONAL INFORMATION

If more than one screen, show locations of each on sketch.