

MISSISSIPPI DEPARTMENT OF NATURAL RESOURCES

Bureau of Land and Water Resources

Southport Mall

P.O. Box 10631

Jackson, Mississippi 39209

WATER WELL DRILLERS LOG

Newton  
A  
2026

7-12-82 19 McDonald's well Newton  
 date well completed firm name county well located

LANDOWNER:	description of formations encountered	from	to
<u>Tommie Shealey</u>	<u>clay &amp; sand</u>	<u>0</u>	<u>23</u>
<u>Rt # 1 Conehatta</u> (mailing address)	<u>shale</u>	<u>23</u>	<u>45</u>
WELL LOCATION:	<u>clay &amp; sand</u>	<u>45</u>	<u>60</u>
sec. <u>34</u> T. <u>8</u> N. R. <u>10</u> E.	<u>shale</u>	<u>60</u>	<u>70</u>
<u>5</u> miles <u>NE</u> of <u>Conehatta</u>	<u>sandy shale &amp; rock</u>	<u>70</u>	<u>140</u>
(distance) (direction) (nearest town)	<u>shale &amp; s&amp;t sand</u>	<u>140</u>	<u>200</u>
WELL PURPOSE: <u>irrig</u> (home, irrigation, municipal, industrial)	<u>sand</u>	<u>200</u>	<u>270</u>
WELL COMPLETION DATA:	<u>sandy shale</u>	<u>270</u>	<u>300</u>
(1) diameter (inches) <u>4"</u>	<u>shale</u>	<u>300</u>	<u>338</u>
(2) total depth (feet) <u>400'</u>	<u>rock &amp; shells</u>	<u>338</u>	<u>365</u>
(3) static water level (feet) <u>185'</u> below top of ground.	<u>green sand</u>	<u>365</u>	<u>380</u>
(4) casing <u>PVC</u> <u>330'</u> (material) (depth)	<u>white sand</u>	<u>380</u>	<u>390</u>
<u>4"</u> (size) if telescope see back.	<u>shale, rock &amp; sand</u>	<u>390</u>	<u>400</u>
(5) screen _____ (length) (depth to top)			
(size) (material)			
(6) pump <u>3/4</u> <u>890W</u> (HP) (yield gpm)			
(type power) <u>X</u>			
(7) electric log _____ (yes or no)			
(organization running log)			
(8) how well bottom plugged <u>open</u>			
DRILLERS REMARKS:			


DEPT. OF NATURAL RESOURCES  
 BUREAU OF LAND & WATER RESOURCES

JUL 19 1982

RECEIVED

If well telescopes please sketch and show depths.

GROUND LEVEL

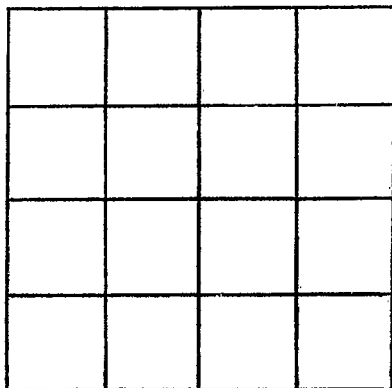

SECTION \_\_\_\_\_

Please indicate well location X.

ADDITIONAL INFORMATION

If more than one screen,  
show locations of each on sketch.