

MISSISSIPPI DEPARTMENT OF NATURAL RESOURCES

Bureau of Land and Water Resources

Southport Mall

P.O. Box 10631

Jackson, Mississippi 39209

WATER WELL DRILLERS LOG

Newton
A
2027

10-31-83
date well completed

McDonald & Hill
firm name

Newton
county well located

LANDOWNER:	description of formations encountered	from	to
<u>Paul Bailey</u>			
<u>Rd # 1 Conhatta</u> (mailing address)	<u>shale</u>	<u>40</u>	<u>60</u>
WELL LOCATION:	<u>sandy shale & rock</u>	<u>60</u>	<u>100</u>
sec. <u>27</u> T. <u>8</u> N. R. <u>10</u> E. W.	<u>shale & sand</u>	<u>100</u>	<u>150</u>
<u>5</u> miles N of <u>Conhatta</u> (distance) (direction) (nearest town)	<u>sand</u>	<u>150</u>	<u>250</u>
WELL PURPOSE: <u>home</u> (home, irrigation, municipal, industrial)	<u>sandy shale</u>	<u>250</u>	<u>280</u>
WELL COMPLETION DATA:	<u>shale</u>	<u>280</u>	<u>325</u>
(1) diameter (inches) <u>4"</u>	<u>rock & shells</u>	<u>325</u>	<u>350</u>
(2) total depth (feet) <u>380</u>	<u>green sand</u>	<u>350</u>	<u>365</u>
(3) static water level (feet) <u>190'</u> below top of ground.	<u>sand & sh shale</u>	<u>365</u>	<u>380</u>
(4) casing <u>PVC</u> <u>305'</u> (material) (depth)			
<u>4"</u> (size) if telescope see back.			
(5) screen _____ (length) (depth to top)			
(size) (material)			
(6) pump <u>1</u> <u>8900</u> (HP) (yield gpm)			
(type power)			
(7) electric log _____ (yes or no)			
(organization running log)			
(8) how well bottom plugged <u>open</u>			

DEPT. OF NATURAL RESOURCES
BUREAU OF LAND & WATER RESOURCES


NOV - 7 1983

RECEIVED

DRILLERS REMARKS:

If well telescopes please sketch and show depths.

GROUND LEVEL

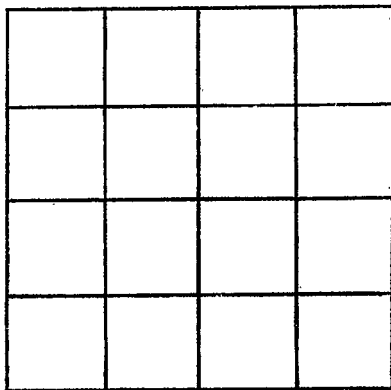

SECTION _____

Please indicate well location X.

ADDITIONAL INFORMATION

If more than one screen,
show locations of each on sketch.