

0 B5 *rechecked*
10-66

WATER WELL DRILLERS LOG **CODED**

P

Date: October, 19 66, Driller: Layne-Central Co. County Newton
(Name)

- (1) Owner of Land: Town of Union
(Name)
At water tank
Union, Mississippi
(Address)
- (2) Location: 1/4, 1/4, Sec. 1 T 8 R 11
_____ miles _____ of _____
(distance) (direction) (Nearest Town)
- (3) Topography: _____
(Hilly) (Flat) (Level)
- (4) Purpose of Well: Municipal
(Domestic Irrigation
Municipal, Industrial, Other)

Information upon completion of well:

- (1) Diameter 18 inches.
- (2) Total Depth 251 feet.
- (3) Water Level 97' feet below top of ground.
- (4) Cased to 185, Size 18"
- (5) Screen: Size 10", Length 50 ft.
- (6) Were any formations sealed against pollution?
✓ yes, _____ no.


ES depth of formation 185'

Required

Drillers Remarks: _____

Description & Color of Materials Sand, Clay, Red Clay, Shell, etc.	Thick- ness Feet	Depth Feet
Clay, Sand, Iron & Rock	17	17
Hard Clay	5	22
Hard Sand Rock	5	27
Hard Clay Rock	4	31
Med. Hard Blue Shale	8	39
Rock, Hard & Soft Stks.	4	43
Green Shale	10	53
Hard Sand Rock	1	54
Black Clay (Hard)	7	61
Hard Sand Rock	3	64
130 Hard Rock & Clay	66	130
Coarse Sand, Little Clay	3	133
Med. Soft Clay, Sand St.	10	143
Coarse Sand, Clay Stks.	7	150
Medium Hard Clay	15	165
Coarse H.P. Sand	43	208
Hard Clay	1	209
Coarse Sand	41	250
Hard Blue Clay	4	254

CODED

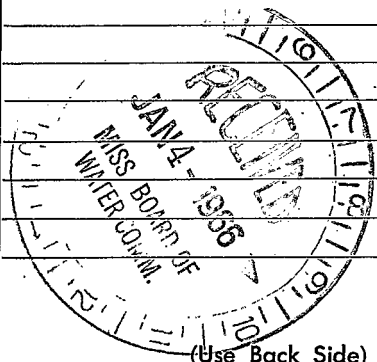

(Use Back Side)

Well No.

1870

1871

1872

1884