

WATER WELL DRILLERS LOG

B 6

7-30-62

Date: 7-30, 1962, Driller: Ray Cook, County: Newton

(Name)

(1) Owner of Land: Hudson Chapel
 (Name) Church
Combita Rd
 (Address)

(2) Location: 1/4, 1/4, Sec. 18-8 T RW
8 miles West, of Union
 (distance) (direction) (Nearest Town)

(3) Topography: X
 (Hilly) (Flat) (Level)

(4) Purpose of Well: Domestic
 (Domestic Irrigation
 Municipal, Industrial, Other)

Description & Color of Materials Sand, Clay, Red Clay, Shell, etc.	Thick- ness Feet	Depth Feet
0-25 White sand		
25-45 Black		
45-55		
From sand white		
55-62 white		
Clean sand		

Information upon completion of well:

(1) Diameter 2 inches.

(2) Total Depth 62 feet.

(3) Water Level 20 feet below top of ground.

(4) Cased to _____, Size _____


(5) Screen: Size 2, Length 5

(6) Were any formations sealed against pollution?
 _____ yes, _____ no.

If YES depth of formation _____

Why _____

Drillers Remarks: _____

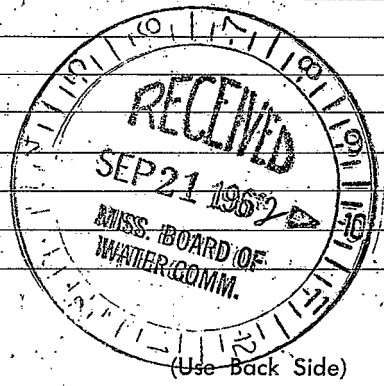

Well No.

