


Newton
B8
10-66

MISSISSIPPI BOARD OF WATER COMMISSIONERS

WATER WELL DRILLERS LOG

T
3

Date: 10-13, 1966, Driller: M. O. Donald County: NEWTON
(When well drilled) (Name) (Where well is located)

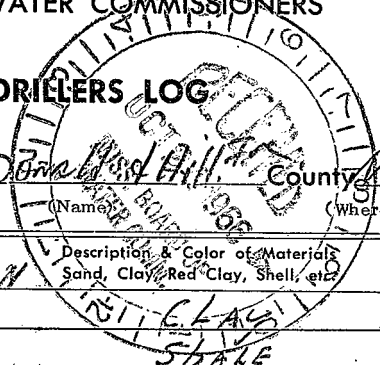

- (1) Owner of Land: BILLY RAY DICKERSON
(Name)
DECATUR MISS
(Address)
- (2) Location: NW 1/4, SW 1/4, Sec. 28 T8 R11, N E
7 miles N. WEST, of DECATUR,
(distance) (direction) (Nearest Town)
- (3) Topography: X
(Hilly) (Flat) (Level)
- (4) Purpose of Well: DOMESTIC
(Domestic Irrigation Municipal, Industrial, Other)


Description & Color of Materials Sand, Clay, Red Clay, Shell, etc.	Thick- ness Feet	Depth Feet
SHALE	18	18
SAND	8	26
SHALE	29	55
SAND	20	75
SAND	40	115
SHALE ST ROCK	75	190
SAND ST ROCK	40	230

Information upon completion of well:

- (1) Diameter 4" WELL inches.
- (2) Total Depth 230 feet.
- (3) Water Level 80 feet below top of ground.
- (4) Cased to 170, Size 4"
- (5) Screen: Size _____, Length _____.
- (6) Were any formations sealed against pollution?
_____ yes, X no.
- If YES depth of formation _____
- Why _____
- Drillers Remarks: _____
- Yield in gpm: 50
- Size pump: _____
- Type power: _____

MS MS

MS 1011

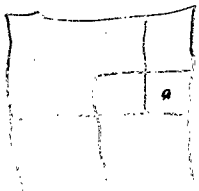

MS 80