

NEWTON

B 10

1-68

MISSISSIPPI
 BOARD OF WATER COMMISSIONERS
 416 North State Street
 Jackson, Mississippi 39201

WATER WELL DRILLERS LOG

1-55 1968 Conservation Drilling Newton
 date well completed firm name county well located

LANDOWNER Boff Lock

description of formations encountered

from to

Union Route 5th

Clay 0 20

Min
(mailing address)

Sand 20 27

WELL LOCATION:

sec 29 T 8 N R 11 E
 S W
6 miles SW of Union
 (distance) (direction) (nearest town)

Clay 27 85
Sand 85 99

WELL PURPOSE: Home
(home, irrigation, municipal, industrial)

WELL COMPLETION DATA:

(1) diameter (inches) 2
 (2) total depth (feet) 99
 (3) static water level (feet) 75 below above
 top of ground.

(4) casing _____ (material), _____ (depth),
 _____ if telescope see back.
 (size)

(5) screen _____ (length), _____ (depth to top)
 _____ (size), _____ (material)

(6) pump _____ (HP), _____ (yield gpm)
 _____ (type power)

(7) electric log _____ (yes or no)
 _____ (organization running log)


(8) how well bottom plugged _____

DRILLERS REMARKS:

NOV-5-1968
 MISS. BOARD OF
 WATER COMM.

If well telescopes please sketch and show depths.

GROUND LEVEL

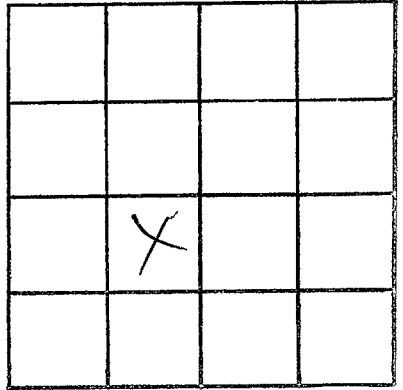

SECTION 29

Please indicate well location X.

ADDITIONAL INFORMATION

If more than one screen, show locations of each on sketch.