

NEWTON

B11

10-16-68

MISSISSIPPI BOARD OF WATER COMMISSIONERS 416 North State Street Jackson, Mississippi 39201

WATER WELL DRILLERS LOG

10-16-68 date well completed

MCDONALD + HILL firm name

NEWTON county well located

LANDOWNER: Johnny Kidd

DECATUR MISS

(mailing address)

WELL LOCATION:

sec 28 T 8 N R 11 E S W 6 miles WEST of DECATUR (distance) (direction) (nearest town)

WELL PURPOSE: FOUNTAIN (home, irrigation, municipal, industrial)

WELL COMPLETION DATA:


- (1) diameter (inches) 4 1/2" WELL
(2) total depth (feet) 460'
(3) static water level (feet) 180' below top of ground.
(4) casing BLK 350' (material) (depth)
4" If telescope see back. (size)
(5) screen (length) (depth to top)
(size) (material)
(6) pump 34 10 (HP) (yield gpm)
220' (type power)
(7) electric log NO (yes or no)
(organization running log)
(8) how well bottom plugged OPEN

description of formations encountered

from to

Table with 2 columns: description of formations encountered, from to. Rows include: CLAY SAND 0 52, SHALE 52 140, SAND ST SHALE 140 210, SOFT SHALE SANDY 310 343, SHALE 343 382, ROCK ST SHALE 382 430, SAND 430 460.


CODE

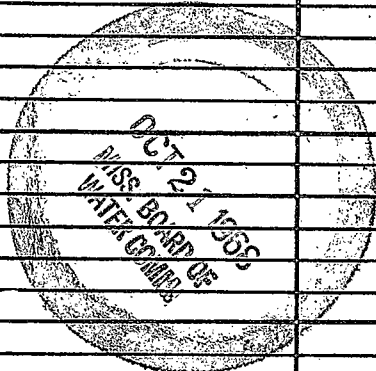

DRILLERS REMARKS:

If well telescopes please sketch and show depths.

GROUND LEVEL

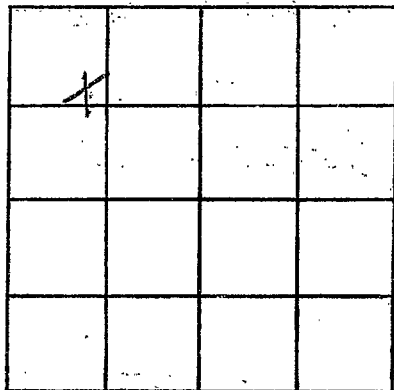

SECTION 28

Please indicate well location X.

ADDITIONAL INFORMATION

If more than one screen,
show locations of each on sketch.