

Newton  
B12  
5-15-69

MISSISSIPPI  
 BOARD OF WATER COMMISSIONERS  
 416 North State Street  
 Jackson, Mississippi 39201

WATER WELL DRILLERS LOG

5-15 1969 R.R. Nicholson Newton  
 date well completed firm name county well located

LANDOWNER: Detemere

Union  
Miss  
 (mailing address)

description of formations encountered

from to

<u>clay</u>	<u>0</u>	<u>18</u>
<u>mid dirt sand</u>	<u>18</u>	<u>65</u>
<u>flint dirt</u>	<u>65</u>	<u>110</u>
<u>water sand</u>	<u>N/A</u>	<u>127</u>

WELL LOCATION:

sec. 29 25 N R. 11 E  
 S W  
3 1/2 miles West of Union  
 (distance) (direction) (nearest town)

WELL PURPOSE: home

(home, irrigation, municipal, industrial)

WELL COMPLETION DATA:

- (1) diameter (inches) 4 1/4"
- (2) total depth (feet) 127
- (3) static water level (feet) 97 below above top of ground.
- (4) casing Gal. P. 127  
 (material) (depth)
- 2"  
 (size) if telescope see back.
- (5) screen 5' 127  
 (length) (depth to top)
- 1 1/4" steel  
 (size) (material)
- (6) pump 1 8  
 (HP) (yield gpm)
- Elect.  
 (type power)
- (7) electric log no  
 (yes or no)

(organization running log)


(8) how well bottom plugged joint

DRILLERS REMARKS:

SEP 17 1969  
 MISS. P.W.C.  
 INSPECTION

If well telescopes please sketch and show depths.

GROUND LEVEL

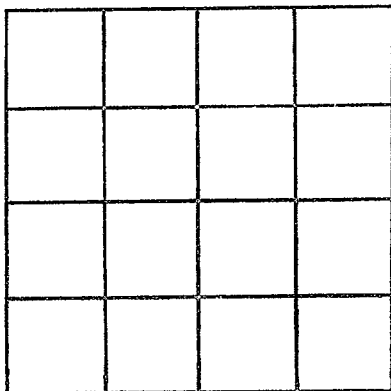

SECTION 29

Please indicate well location X.

ADDITIONAL INFORMATION

If more than one screen, show locations of each on sketch.