

Newton
B 14
7-8-69

MISSISSIPPI
 BOARD OF WATER COMMISSIONERS
 416 North State Street
 Jackson, Mississippi 39201

WATER WELL DRILLERS LOG


7-8 1969 RR Nicholson Newton
 date well completed firm name county well located

LANDOWNER: <u>OC Eason</u>	description of formations encountered	from	to
<u>Union</u> <u>Miss</u> (mailing address)			
	<u>W. Hint & Chalk</u>	<u>0</u>	<u>33</u>
	<u>W. Sand</u>	<u>33</u>	<u>85</u>
	<u>water sand bed</u>	<u>85</u>	<u>105</u>
	<u>blue hint</u>	<u>105</u>	<u>250</u>
	<u>rock</u>	<u>250</u>	<u>251</u>
	<u>green water sand</u>	<u>251</u>	<u>273</u>
WELL LOCATION: sec. <u>29</u> T. <u>8</u> N. R. <u>11</u> E <u>1/2</u> miles <u>West</u> of <u>Union</u> (distance) (direction) (nearest town)			
WELL PURPOSE: <u>home</u> (home, irrigation, municipal, industrial)			
WELL COMPLETION DATA: (1) diameter (inches) <u>4 1/4</u> (2) total depth (feet) <u>273</u> (3) static water level (feet) <u>90</u> below above top of ground. (4) casing <u>galv.</u> <u>210'</u> (material) (depth) <u>4 1/2"</u> if telescope see back. (size) (5) screen <u>✓</u> (length) (depth to top) (size) (material) (6) pump _____ (HP) _____ (yield gpm) (type power) (7) electric log _____ (yes or no) (organization running log) (8) how well bottom plugged <u>open</u>			
DRILLERS REMARKS:			

SEP 9 1969
 MISS. DEPT. OF WATER CONTROL

If well telescopes please sketch and show depths.

GROUND LEVEL

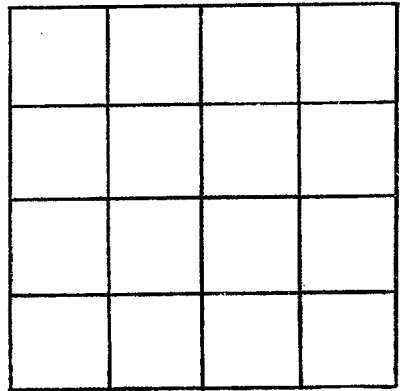

SECTION 29

Please indicate well location X.

ADDITIONAL INFORMATION

Lined area for additional information.

If more than one screen, show locations of each on sketch.