

CODED

Newton
B 15.
7-3-69

MISSISSIPPI
BOARD OF WATER COMMISSIONERS
416 North State Street
Jackson, Mississippi 39201

WATER WELL DRILLERS LOG

7-3 1969 B R R Nicholson Newton
date well completed firm name county well located

LANDOWNER: Mrs. Sma. Nicholson
Union
Miss. (mailing address)

description of formations encountered	depth	
	from	to
Mix. Chalk & dirt	0	20
Blue dirt	20	130
Sand water bed	130	147
Blue dirt	147	270
Rock	270	290
Rock	270	271
Green Sand	270	290

WELL LOCATION:
sec. 29 T 8 N R 11 E
S W
9 miles west Union
(distance) (direction) (nearest town)

WELL PURPOSE: Home
(home, irrigation, municipal, industrial)


- WELL COMPLETION DATA:
- (1) diameter (inches) 4 1/4
 - (2) total depth (feet) 290
 - (3) static water level (feet) 98 below above top of ground.
 - (4) casing Galv. P. 2 1/2"
(material) (depth)
2" if telescope see back.
(size)
 - (5) screen (length) (depth to top)
(size) (material)
 - (6) pump 1/2 (HP) 4 (yield gpm.)
Elect. (type power)
 - (7) electric log no (yes or no)
 - (8) how well bottom plugged _____
(organization running log)

SEP 9 1969
MISS. Bd. OF WATER COM. (stamp)

DRILLERS REMARKS:

If well telescopes please sketch and show depths.

GROUND LEVEL

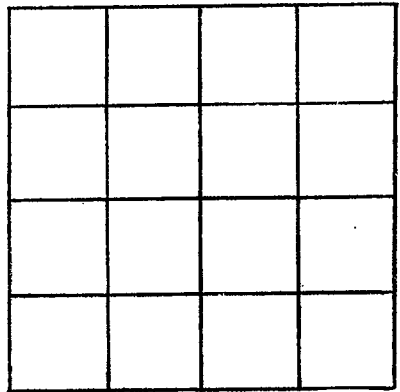

SECTION 29

Please indicate well location X.

ADDITIONAL INFORMATION

A series of horizontal lines for entering additional information.

If more than one screen, show locations of each on sketch.