

Newton
B16
7-68

MISSISSIPPI
BOARD OF WATER COMMISSIONERS
416 North State Street
Jackson, Mississippi 39201

WATER WELL DRILLERS LOG

7-24-68 date well completed
McDONALD + HILL firm name
NEWTON county well located

LANDOWNER: BILLY BUFFIN
R#1 DECATUR

description of formations encountered	from	to
Clay lt sand	0	38
shale	38	60
sand	60	140
shale	140	200
sand	200	315
shale	315	400
sand	400	420
sand	420	440

(mailing address)

WELL LOCATION:
sec. 34 T. 8 N R. 11 E
S W
6 miles WEST of DECATUR
(distance) (direction) (nearest town)

WELL PURPOSE: HOME
(home, irrigation, municipal, industrial)

WELL COMPLETION DATA:


- diameter (inches) 4 1/2
- total depth (feet) 440
- static water level (feet) 168 below above top of ground.
- casing BLK, 330'
(material) (depth)
4" If telescope see back.
(size)
- screen _____
(length) (depth to top)
(size) (material)
- pump 34 18
(HP) (yield gpm)
220
(type power)
- electric log NO
(yes or no)
(organization running log)
- how well bottom plugged OPEN

JUL 20 1968
MISS. BOARD OF
WATER COMMISSIONERS

DRILLERS REMARKS:

If well telescopes please sketch and show depths.

GROUND LEVEL

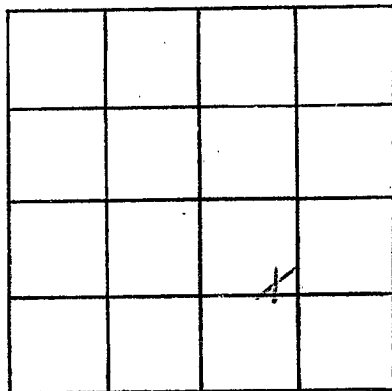

SECTION _____

Please indicate well location X.

ADDITIONAL INFORMATION

If more than one screen, show locations of each on sketch.