

CODED

CODED

Newton
B19
11-1-69

MISSISSIPPI
BOARD OF WATER COMMISSIONERS
416 North State Street
Jackson, Mississippi 39201

WATER WELL DRILLERS LOG

11-1 1969 RR Nicholson Newton
date well completed firm name county well located

LANDOWNER: <u>Barnwell Smith</u>	description of formations encountered	from	to
(mailing address)			
<u>Union</u>	<u>Clay</u>	<u>0</u>	<u>11</u>
<u>Mias</u>	<u>Med Sand & Clay</u>	<u>11</u>	<u>28</u>
	<u>Water Sand</u>	<u>28</u>	<u>37</u>

WELL LOCATION:
sec. 3 T 8 N R 11 E
S W
5 miles E. of Union
(distance) (direction) (nearest town)

WELL PURPOSE: home
(home, irrigation, municipal, industrial)

- WELL COMPLETION DATA:
- (1) diameter (inches) 4 1/4
 - (2) total depth (feet) 37
 - (3) static water level (feet) 24 below above top of ground.
 - (4) casing galv. p. 32
(material) (depth)
2" if telescope see back.
(size)
 - (5) screen 5- steel 32'
(length) (depth to top)
1 1/4 steel
(size) (material)
 - (6) pump 1/2 6
(HP) (yield gpm)
elect.
(type power)
 - (7) electric log _____
(yes or no)
 - _____
(organization running log)
 - (8) how well bottom plugged _____


JAN 21 1970

MISS. BD. OF
WATER COM.

DRILLERS REMARKS:

If well telescopes please sketch and show depths.

GROUND LEVEL

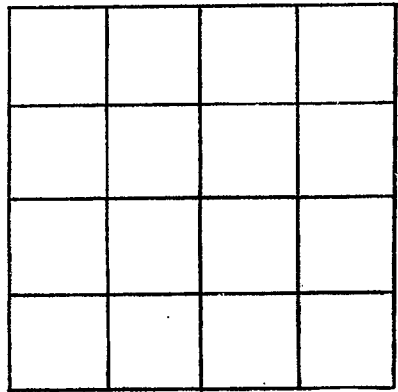

SECTION 3

Please indicate well location X.

ADDITIONAL INFORMATION

A series of horizontal lines for entering additional information, starting below the 'ADDITIONAL INFORMATION' header and extending to the bottom of the page.

If more than one screen, show locations of each on sketch.