

Newton Co
B 21
5-12-70

MISSISSIPPI
 BOARD OF WATER COMMISSIONERS
 416 North State Street
 Jackson, Mississippi 39201

WATER WELL DRILLERS LOG

5-12-70 19 McDONALD HILL NEWTON
 date well completed firm name county well located


LANDOWNER:	description of formations encountered	from	to
TONEY ETELL	CLAY	0	18
RH DECATUR (mailing address)	SAND	18	90
WELL LOCATION:			
sec <u>34 T 8 S</u> R <u>11 E</u> <u>008</u>			
1 miles <u>WEST</u> of <u>STRATTON</u> (distance) (direction) (nearest town)			
WELL PURPOSE: <u>HOME</u> (home, irrigation, municipal, industrial)			
WELL COMPLETION DATA:			
(1) diameter (inches) <u>2"</u>			
(2) total depth (feet) <u>90'</u>			
(3) static water level (feet) <u>22'</u> below above top of ground.			
(4) casing <u>Galv</u> <u>84'</u> (material) (depth)			
<u>2"</u> (size) if telescope see back.			
(5) screen <u>5'</u> <u>84'</u> (length) (depth to top)			
<u>2"</u> <u>PVC</u> (size) (material)			
(6) pump <u>1/2</u> <u>5</u> (HP) (yield gpm)			
<u>115</u> (type power)			
(7) electric log <u>NO</u> (yes or no)			
<u>NO</u> (organization running log)			
(8) how well bottom plugged <u>VALUE</u>			
DRILLERS REMARKS:			

MAY 18 1970

MISS. BD. OF
 WATER COMM.

If well telescopes please sketch and show depths.

GROUND LEVEL

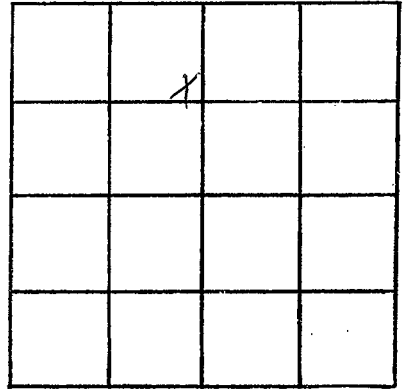

SECTION _____

Please indicate well location X.

ADDITIONAL INFORMATION

A series of horizontal lines for entering additional information, consisting of approximately 25 lines.

If more than one screen, show locations of each on sketch.