

Newton  
B 23  
5-15-70

MISSISSIPPI  
 BOARD OF WATER COMMISSIONERS  
 416 North State Street  
 Jackson, Mississippi 39201

**CODED**

WATER WELL DRILLERS LOG

5-15 1970 BBT Nicholson Newton  
 date well completed firm name county well located

LANDOWNER: <u>Dallas Seroun</u>	description of formations encountered	from	to
<u>Union</u>			
<u>Miss-</u>	<u>Shell &amp; bit</u>	<u>35</u>	<u>42</u>
(mailing address)	<u>mix dirt &amp; sand</u>	<u>42</u>	<u>70</u>
	<u>Water Sand</u>	<u>70</u>	<u>87</u>

WELL LOCATION:  
 sec. 30 T. 8 N. R. 11 E.  
10 mi miles West of Union  
 (distance) (direction) (nearest town)

WELL PURPOSE: Home  
 (home, irrigation, municipal, industrial)

- WELL COMPLETION DATA:
- (1) diameter (inches) 4 1/4
  - (2) total depth (feet) 87
  - (3) static water level (feet) 68 below above top of ground.
  - (4) casing galv. 82  
 (material) (depth)  
2" if telescope see back.  
 (size)
  - (5) screen 5- 87  
 (length) (depth to top)  
1 1/4 Steel  
 (size) (material)
  - (6) pump 1 17  
 (HP) (yield gpm)  
Elect  
 (type power)
  - (7) electric log NO  
 (yes or no)
- (organization running log)
- (8) how well bottom plugged Screen

**CODED**


JUL 24 1970

DRILLERS REMARKS:

MISS. BD. OF  
 WATER COMM.

If well telescopes please sketch and show depths.

GROUND LEVEL

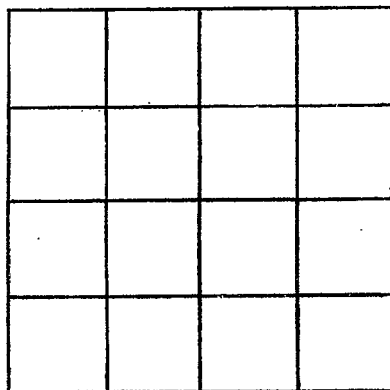

SECTION \_\_\_\_\_

Please indicate well location X.

ADDITIONAL INFORMATION

If more than one screen, show locations of each on sketch.