

NEWTON
B26
9-30-70

MISSISSIPPI
 BOARD OF WATER COMMISSIONERS
 416 North State Street
 Jackson, Mississippi 39201

CODED

WATER WELL DRILLERS LOG

9-30 date well completed 70 R R Richardson firm name Newton county well located

LANDOWNER: <u>Earl Zwall</u>	description of formations encountered	from	to
<u>John</u> <u>Miss</u> (mailing address)			
	<u>Clay</u>	<u>0</u>	<u>18</u>
	<u>Sand & Chalk</u>	<u>18</u>	<u>32</u>
	<u>water Sand</u>	<u>32</u>	<u>42</u>

WELL LOCATION:
 sec. 19 T. 8 N. R. 11 E.
11 miles West of Union
 (distance) (direction) (nearest town)

WELL PURPOSE: home
 (home, irrigation, municipal, industrial)

- WELL COMPLETION DATA:
- (1) diameter (inches) 4 1/4
 - (2) total depth (feet) 42
 - (3) static water level (feet) 33 below above top of ground.
 - (4) casing galv (material) 37 (depth)
2" (size) if telescope see back.
 - (5) screen 5' (length) 42 (depth to top)
1/4" (size) steel (material)
 - (6) pump 1 (HP) 12 (yield gpm)
Elect (type power)
 - (7) electric log (yes or no) _____
 _____ (organization running log)
 - (8) how well bottom plugged _____

CODED


DEC 15 1970

MISS. BD. OF
 WATER COMM.

DRILLERS REMARKS: _____

If well telescopes please sketch and show depths.

GROUND LEVEL

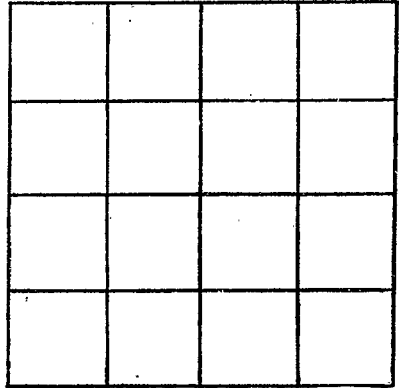

SECTION _____

Please indicate well location X.

ADDITIONAL INFORMATION

If more than one screen, show locations of each on sketch.