

B27  
9-10-60

6 13T

WATER WELL DRILLERS LOG

CODED  
2  
10

Date: 9-10, 1960, Driller: B. R. Nicholson, County: Washington  
(Name)

(1) Owner of Land: W. L. Crowder  
(Name)

Union Miss  
(Address)

Description & Color of Materials Sand, Clay, Red Clay, Shell, etc.	Thick- ness Feet	Depth Feet
Sand & clay	1	80
water sand	80	90

(2) Location: 1/4, 1/4, Sec. 22 T 8 R 11  
8 miles SW of Union  
(distance) (direction) (Nearest Town)

(3) Topography:  
(Hilly) (Flat) (Level)

(4) Purpose of Well: Domestic  
(Domestic Irrigation  
Municipal, Industrial, Other)

Information upon completion of well:

(1) Diameter 4 inches.

(2) Total Depth 90 feet.

(3) Water Level 70 feet below top of ground.

(4) Cased to bottom, Size 2'

(5) Screen: Size 2", Length 6'

(6) Were any formations sealed against pollution?  
\_\_\_\_\_ yes, \_\_\_\_\_ no.


If YES depth of formation \_\_\_\_\_

Why \_\_\_\_\_

Drillers Remarks: good well

CODED

CODED

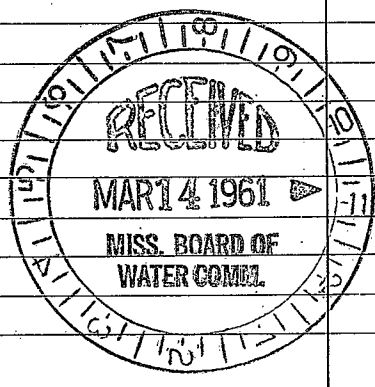

Well No.

(Use Back Side)

[The page contains extremely faint and illegible text, likely bleed-through from the reverse side of the document. The text is scattered across the page and cannot be transcribed accurately.]