

B29
4-13-61

WATER WELL DRILLERS CODED

Date: 4/13, 19 61, Driller: Hester, Augustine County Newton
(Name)

- (1) Owner of Land: J. G. Harper
(Name)
R. 1 Little Rock Miss
(Address)
- (2) Location: $\frac{1}{4}$, 6 8 11 R,
6 miles West of Union
(distance) (direction) (Nearest Town)
- (3) Topography: Hilly
(Hilly) (Flat) (Level)
- (4) Purpose of Well: Home use
(Domestic Irrigation
Municipal, Industrial, Other)


Description & Color of Materials Sand, Clay, Red Clay, Shell, etc.	Thick- ness Feet	Depth Feet
36 ft. clay & sand		
104 ft. heavy dirt with shell rock		
30 ft. water sand		

CODED

Information upon completion of well:

- (1) Diameter 4 1/2 inches.
- (2) Total Depth 170 feet.
- (3) Water Level 130 feet below top of ground.
- (4) Cased to 164, Size 9 inch.
- (5) Screen: Size 1 1/4, Length 6 ft.
- (6) Were any formations sealed against pollution?
 yes, no.

If YES depth of formation _____
Why _____
Drillers Remarks: _____

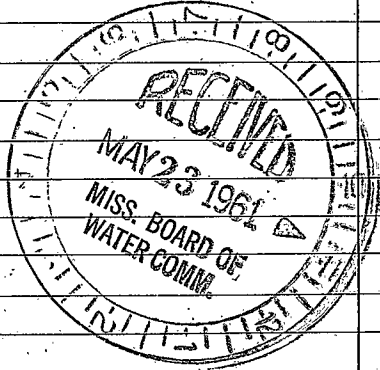

(Use Back Side)

Well No. _____

