

Newton
B33
10-21-71

MISSISSIPPI
 BOARD OF WATER COMMISSIONERS
 416 North State Street
 Jackson, Mississippi 39201
WATER WELL DRILLERS LOG

CODED

10-21 date well completed 1st Cement Drilling in Newton firm name Newton county well located

LANDOWNER: Ray Ezell
Union Miss
 (mailing address)

description of formations encountered	from	to
<u>Clay</u>	<u>0</u>	<u>89</u>
<u>SAND</u>	<u>89</u>	<u>160</u>

WELL LOCATION:
 sec. 14 T. 8 N. R. 11 E.
3 miles SW of Union
 (distance) (direction) (nearest town)

WELL PURPOSE: Home
 (home, irrigation, municipal, industrial)

- WELL COMPLETION DATA:
- (1) diameter (inches) 2
 - (2) total depth (feet) 169
 - (3) static water level (feet) 50 below above top of ground.
 - (4) casing Steel, 105
 (material) (depth)
 (size) if telescope see back.
 - (5) screen 4" 105
 (length) (depth to top)
 (size) (material)
 - (6) pump None 4
 (HP) (yield gpm)
Electric
 (type power)
 - (7) electric log No
 (yes or no)
 (organization running log)
 - (8) how well bottom plugged _____

CODED


APR 12 1972

MISS. BD. OF
 WATER COMMISSIONERS

DRILLERS REMARKS:

If well telescopes please sketch and show depths.

GROUND LEVEL

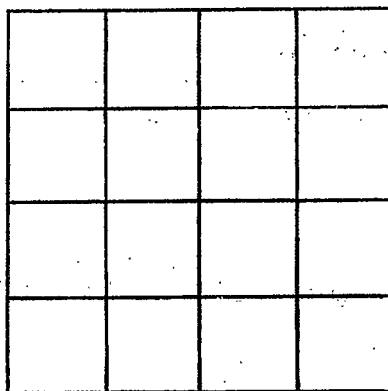

SECTION _____

Please indicate well location X.

ADDITIONAL INFORMATION

If more than one screen, show locations of each on sketch.