

Newton
B 37
2-19-73

MISSISSIPPI
BOARD OF WATER COMMISSIONERS
416 North State Street
Jackson, Mississippi 39201

118

CODED

WATER WELL DRILLERS LOG

2.19.73, McDONNELL & HILL, NEWTON
date well completed firm name county well located

LANDOWNER:

L.O. DRISKELL
UNION MISS
(mailing address)

description of formations encountered

from to

CLAY SAND	0	35
SAND	35	65
SHALE	65	124
ROCK STRATA	124	136
ROCK STRATA	136	152
SAND	152	180

WELL LOCATION:

sec 3 T-8 R 11
3 miles WEST of UNION
(distance) (direction) (nearest town)

WELL PURPOSE:

HOME
(home, irrigation, municipal, industrial)

WELL COMPLETION DATA:

- (1) diameter (inches) 4 1/2
- (2) total depth (feet) 180'
- (3) static water level (feet) 118' below top of ground
- (4) casing PVC 120'
(material) (depth)
4 1/2" if telescope see back.
(size)
- (5) screen 10' 168'
(length) (depth to top)
2 1/2" PVC
(size) (material)
- (6) pump 3/4 HP 4
(HP) (yield gpm)
220
(type power)
- (7) electric log N/S
(yes or no)
N/S
(organization running log)
- (8) how well bottom plugged VALVE


CODED

DRILLERS REMARKS:

FEB 23 1973

If well telescopes please
sketch and show depths.

GROUND LEVEL

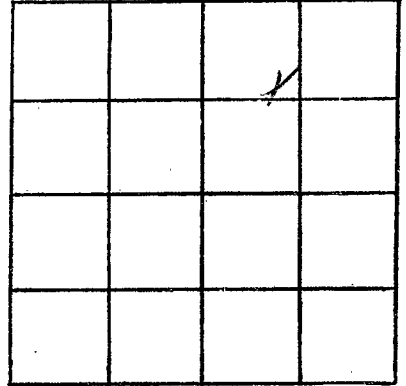

SECTION _____

Please indicate well location X.

ADDITIONAL INFORMATION

If more than one screen,
show locations of each on sketch.