

B 40
 Newton
 6/2/75

MISSISSIPPI
 BOARD OF WATER COMMISSIONERS
 416 North State Street
 Jackson, Mississippi 39201

CODED

WATER WELL DRILLERS LOG

6-2-75 19 McDonald + Hill NEWTON
 date well completed firm name county well located

LANDOWNER:
 Billy Smith
 Rt 2 Union
 (mailing address)


WELL LOCATION:
 sec. 38 T 8 N R 11 E
 7 miles S WEST of Union
 (distance) (direction) (nearest town)

WELL PURPOSE: HOME
 (home, irrigation, municipal, industrial)

- WELL COMPLETION DATA:
- (1) diameter (inches) 4 1/2
 - (2) total depth (feet) 260'
 - (3) static water level (feet) 90' below top of ground
 - (4) casing PVC 178' (material) (depth)
 4 1/2 (size) If telescope see back.
 - (5) screen (length) (depth to top)
 (size) (material)
 - (6) pump 1/2 sub 10 (HP) (yield gpm)
 Electric (type power)
 - (7) electric log (yes or no)
 (organization running log)
 - (8) how well bottom plugged OPEN

description of formations encountered	from	to
Clay St Sand	0	50
Shale	50	56
Sand	56	140
Salt Sand	140	165
Shale Sand	165	175
Med Shale	175	206
Red St Shale	206	220
Wash St Sand	220	240
Green Sand	240	268

CODED

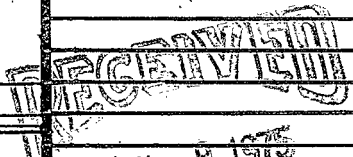

JUN 9 1975


MISSISSIPPI BOARD OF WATER COMMISSIONERS

DRILLERS REMARKS:
 Drilled to 260' and
 1' shale

If well telescopes please sketch and show depths.

X

GROUND LEVEL

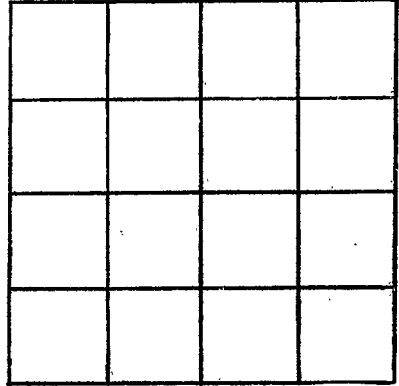

SECTION _____

Please indicate well location X.

ADDITIONAL INFORMATION

If more than one screen, show locations of each on sketch.