

**NEWTON**  
**B 2000**  
**8-9-76**

MISSISSIPPI  
 BOARD OF WATER COMMISSIONERS  
 416 North State Street  
 Jackson, Mississippi 39201

~~Can't be Newton~~  
 transfer location  
 9/2/76

**WATER WELL DRILLERS LOG**

8.9.76 date well completed  
 13P McDonald + Hill firm name  
 NEWTON county well located

**LANDOWNER:**  
 Coy McMOLLAN  
 RR 1 DECATUR  
 (mailing address)

**WELL LOCATION:**  
 sec 26 T 4N R 17E  
 3 miles NORTH of DECATUR  
 (distance) (direction) (nearest town)

**WELL PURPOSE:** HOME  
 (home, irrigation, municipal, industrial)


- WELL COMPLETION DATA:**
- (1) diameter (inches) 4"
  - (2) total depth (feet) 198'
  - (3) static water level (feet) 90' below top of ground.
  - (4) casing PVC 112' (material) (depth)  
 4" (size) if telescope see back.
  - (5) screen (length) (depth to top)  
 (size) (material)
  - (6) pump 1/2 sub 6 (HP) (yield gpm)  
 E (type power)
  - (7) electric log (yes or no)  
 (organization running log)
  - (8) how well bottom plugged OPEN

description of formations encountered	from	to
	Cloy Sand	0
Shale	42	50
Sand	50	85
Shale	85	118
Rock ST Shale	118	140
GREEN SAND	140	150
Shale	150	165
White Sand	165	198

**DRILLERS REMARKS:**

If well telescopes please sketch and show depths.

GROUND LEVEL

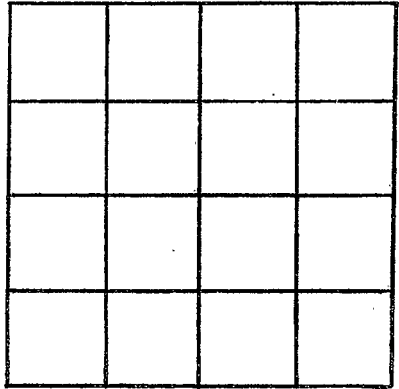

SECTION \_\_\_\_\_

Please indicate well location X.

ADDITIONAL INFORMATION

If more than one screen, show locations of each on sketch.