

Newton
B 2001
8-24-76

These people just make up a
MISSISSIPPI Township & Range
BOARD OF WATER COMMISSIONERS
416 North State Street
Jackson, Mississippi 39201 (Wonder about section?)

WATER WELL DRILLERS LOG

8.24.76 1976 McDONALD + Co NEWTON
date well completed firm name county well located

LANDOWNER:	description of formations encountered	from	to
<u>KENDRICKS</u>	<u>Clay</u>	<u>0</u>	<u>16</u>
<u>Rt 2 UNION</u> (mailing address)	<u>Clay sand</u>	<u>16</u>	<u>95</u>
WELL LOCATION: sec. <u>26</u> T <u>B</u> N R <u>14</u> E S W <u>6</u> miles <u>SWEST</u> of <u>UNION</u> (distance) (direction) (nearest town)	<u>Shale</u>	<u>95</u>	<u>146</u>
WELL PURPOSE: <u>Home</u> (home, irrigation, municipal, industrial)	<u>sand</u>	<u>140</u>	<u>168</u>
WELL COMPLETION DATA: (1) diameter (inches) <u>4 1/2</u>	<u>Soft Shale</u>	<u>168</u>	<u>190</u>
(2) total depth (feet) <u>295'</u>	<u>Rock</u>	<u>190</u>	<u>194'</u>
(3) static water level (feet) _____ below/above top of ground.	<u>Rock</u>	<u>194</u>	<u>235</u>
(4) casing <u>PVC</u> <u>230'</u> (material) (depth)	<u>Rock</u>	<u>235</u>	<u>270</u>
<u>4"</u> (size) If telescope see back.	<u>sand</u>	<u>270</u>	<u>295</u>
(5) screen _____ (length) (depth to top)			
(size) _____ (material)			
(6) pump <u>34 Sub 10</u> (HP) (yield gpm)			
<u>E</u> (type power)			
(7) electric log _____ (yes or no)			
(organization running log)			
(8) how well bottom plugged <u>OPEN</u>			
DRILLERS REMARKS:			


RECEIVED

AUG 30 1976

MISS. RD. OF WATER COMMISSIONERS

If well telescopes please sketch and show depths.

GROUND LEVEL

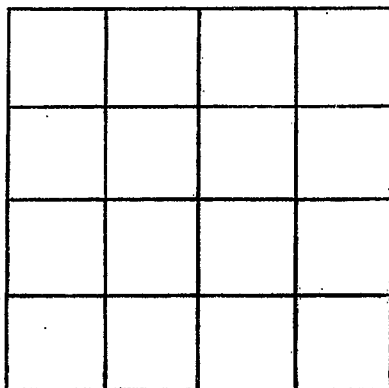

SECTION _____

Please indicate well location X.

ADDITIONAL INFORMATION

If more than one screen,
show locations of each on sketch.