

Newton  
B 2002  
8-25-76

MISSISSIPPI  
 BOARD OF WATER COMMISSIONERS  
 416 North State Street  
 Jackson, Mississippi 39201

WATER WELL DRILLERS LOG

8-25-76 19 McDonald NEWTON  
 date well completed firm name county well located

LANDOWNER:  
GLEEN VANCE  
R#2 CONEBATTA  
 (mailing address)  
 WELL LOCATION:  
 sec. 34 T B N 2 R 14 E  
6 miles S WEST UNION  
 (distance) (direction) of (nearest town)

description of formations encountered	from	to
<u>Clay</u>	<u>0</u>	<u>16</u>
<u>Shale</u>	<u>16</u>	<u>42</u>
<u>Sand</u>	<u>42</u>	<u>150</u>
<u>Sand</u>	<u>150</u>	<u>162</u>
<u>RMK</u>	<u>162</u>	<u>163</u>

WELL PURPOSE: HOME  
 (home) irrigation, municipal, industrial

<u>Sand</u>	<u>163</u>	<u>170</u>
-------------	------------	------------

WELL COMPLETION DATA:  
 (1) diameter (inches) 4"  
 (2) total depth (feet) 280'  
 (3) static water level (feet) 10' below top of ground.  
 (4) casing 4" PVC (material) 210' (depth).  
4" (size) if telescope see back.  
 (5) screen (length) (depth to top) \_\_\_\_\_  
 (size) (material) \_\_\_\_\_  
 (6) pump 1/2 (HP) 10 (yield.gpm)  
E (type power)  
 (7) electric log \_\_\_\_\_ (yes or no)  
 (organization running log) \_\_\_\_\_  
 (8) how well bottom plugged OPEN

<u>Shale</u>	<u>170</u>	<u>223</u>
<u>Rock Str. Shale</u>	<u>223</u>	<u>240</u>
<u>Sand</u>	<u>240</u>	<u>280</u>


RECEIVED  
 AUG 30 1976

DRILLERS REMARKS:

MISS. BD. OF WATER COMMISSIONERS

If well telescopes please sketch and show depths.

GROUND LEVEL

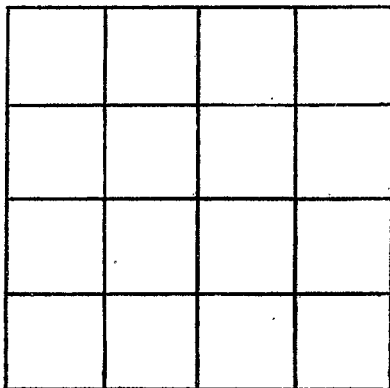

SECTION \_\_\_\_\_

Please indicate well location X.

ADDITIONAL INFORMATION

If more than one screen, show locations of each on sketch.