

NEWTON
B 2003
3-17-77

MISSISSIPPI
 BOARD OF WATER COMMISSIONERS
 416 North State Street
 Jackson, Mississippi 39201

WATER WELL DRILLERS LOG

3-17-77 ^{13T} McDonald + Well Newton
 date well completed firm name county well located

LANDOWNER:
Jenita Jackson
Union
 (mailing address)

description of formations encountered	from	to
<u>clay</u>	<u>0</u>	<u>20</u>
<u>shale, ST Rock, + sand</u>	<u>20</u>	<u>50</u>

WELL LOCATION:
 sec. 1 T 8 N 11 E
 S W
 miles 10 of Union
 (distance) (direction) (nearest town)

description of formations encountered	from	to
<u>sand</u>	<u>50</u>	<u>70</u>

WELL PURPOSE: home
 (home, irrigation, municipal, industrial)

- WELL COMPLETION DATA:
- (1) diameter (inches) 2"
 - (2) total depth (feet) 70'
 - (3) static water level (feet) 47' below above top of ground.
 - (4) casing PVC 65
 (material) (depth)
2"
 (size) If telescope see back.
 - (5) screen 5' 65 to 70
 (length) (depth to top)
2" PVC
 (size) (material)
 - (6) pump 3/4 59PM
 (HP) (y/d gpm)
F
 (type power)
 - (7) electric log (yes or no) _____
 (organization running log) _____
 - (8) how well bottom plugged _____

RECEIVED


MAR 28 1977

DRILLERS REMARKS:

MISSISSIPPI BOARD OF WATER COMMISSIONERS

If well telescopes please sketch and show depths.

GROUND LEVEL

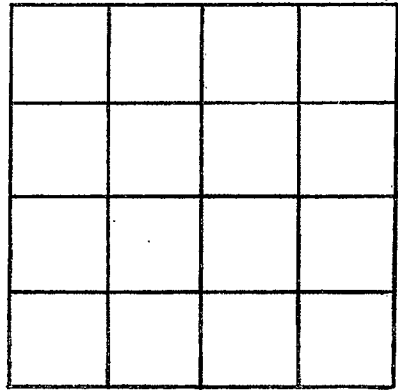

SECTION _____

Please indicate well location X.

ADDITIONAL INFORMATION

If more than one screen,
show locations of each on sketch.