

Newton  
B 2004  
4-7-77

MISSISSIPPI  
BOARD OF WATER COMMISSIONERS  
416 North State Street  
Jackson, Mississippi 39201

WATER WELL DRILLERS LOG

13T

4-7-77 19 McDonald, R. L. Newton  
date well completed firm name county well located

LANDOWNER:  
Billy Chaney  
Rt 1 Decatur  
(mailing address)

WELL LOCATION:  
sec. 29 T. 3 N. R. 11 E  
8 1/2 miles SW of Union  
(distance) (direction) (nearest town)

WELL PURPOSE:  
(home, irrigation, municipal, industrial)

WELL COMPLETION DATA:

- (1) diameter (inches) 4"
- (2) total depth (feet) 280'
- (3) static water level (feet) 25' below above top of ground.
- (4) casing PVC, 180'  
(material) (depth)  
4"  
(size) if telescope see back.
- (5) screen — —  
(length) (depth to top)  
— —  
(size) (material)
- (6) pump 1/2 6000  
(HP) (x) gal/d gpm  
E  
(type power)
- (7) electric log —  
(yes or no)  
—  
(organization running log)
- (8) how well bottom plugged Open

description of formations encountered	from	to
<u>sand + clay</u>	<u>0</u>	<u>50</u>
<u>sand st shale lignite</u>	<u>50</u>	<u>140</u>
<u>sandy shale</u>	<u>140</u>	<u>175</u>
<u>shale</u>	<u>175</u>	<u>220</u>
<u>Rock + shale</u>	<u>220</u>	<u>245</u>
<u>green sand sandy shale</u>	<u>245</u>	<u>280</u>

**RECEIVED**


APR 11 1977

MISS. BD OF WATER COMM

DRILLERS REMARKS:

If well telescopes please sketch and show depths.

GROUND LEVEL

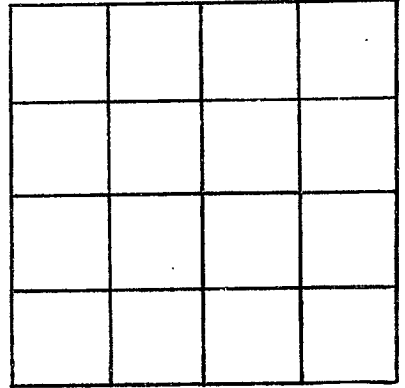

SECTION \_\_\_\_\_

Please indicate well location X.

ADDITIONAL INFORMATION

If more than one screen,  
show locations of each on sketch.