

NEWTON  
B 2005  
5-11-77

MISSISSIPPI  
BOARD OF WATER COMMISSIONERS  
416 North State Street  
Jackson, Mississippi 39201

137

WATER WELL DRILLERS LOG

5-11 date well completed  
1977 firm name  
Cowan Drilling Newton county well located

LANDOWNER:

Oliver Hollenworth  
Decatur Rte 2 MS  
(mailing address)

description of formations encountered

from

to

Clay 0 20  
Sand 20 80

WELL LOCATION:

sec. 24 T 80 N R 11 E  
S W  
3 miles N of Stratton  
(distance) (direction) (nearest town)

WELL PURPOSE:

Home  
(home, irrigation, municipal, industrial)

WELL COMPLETION DATA:

- (1) diameter (inches) 2"
- (2) total depth (feet) 80
- (3) static water level (feet) 30 below top of ground.
- (4) casing PVC 75' (material) (depth)  
if telescope see back.  
(size)
- (5) screen 5' 75' (length) (depth to top)  
2" PVC (size) (material)
- (6) pump 1/2 HP 5 (yield gpm)  
E (type power)
- (7) electric log 120 (yes or no)
- (organization running log)
- (8) how well bottom plugged


RECEIVED  
JUN 25 1977

DRILLERS REMARKS:

MISS. BOARD OF WATER COMMISSIONERS

If well telescopes please sketch and show depths.

GROUND LEVEL

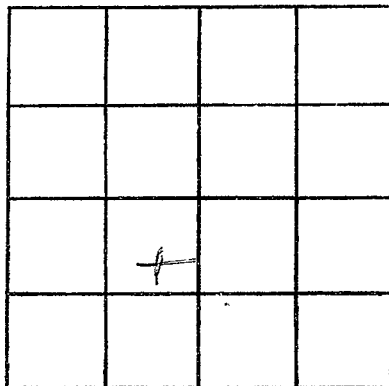

SECTION 28

Please indicate well location X.

ADDITIONAL INFORMATION

If more than one screen, show locations of each on sketch.