

NEWTON
B 2006
6-6-77

MISSISSIPPI
BOARD OF WATER COMMISSIONERS
416 North State Street
13P Jackson, Mississippi 39201

WATER WELL DRILLERS LOG

6-6 1977 Common Drilling & Newton
date well completed firm name county well located

LANDOWNER: George M. Smith
Residence RTH Mrs

description of formations encountered from to

(mailing address)

Clay 0 25

WELL LOCATION:
sec. 13 T. 8 N. R. 11 E

Sand 25 36

2 miles S of Newton
(distance) (direction) (nearest town)

Clay + Sand 36 148

WELL PURPOSE: MUNICIPAL
(home, irrigation, municipal, industrial)

Sand + Clay 148 190

WELL COMPLETION DATA:

Sand 190 185

(1) diameter (inches) 9"

(2) total depth (feet) 185

(3) static water level (feet) 118 below above top of ground.

(4) casing PVC 180
(material) (depth)
(size) if telescope see back.

(5) screen 5 180
(length) (depth to top)

2" PVC
(size) (material)

(6) pump 1 4
(HP) (yield gpm)

F
(type power)

(7) electric log NO
(yes or no)

(organization running log)

(8) how well bottom plugged


DRILLERS REMARKS:

RECEIVED
JUN 15 1977

MISS. BD. OF WATER COMMISSIONERS

If well telescopes please sketch and show depths.

GROUND LEVEL

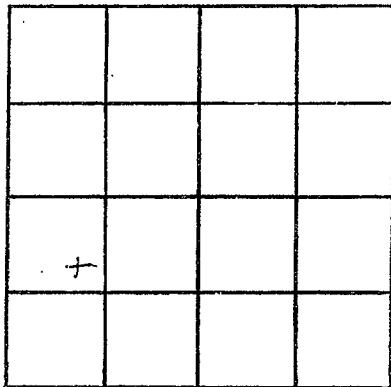

SECTION 1.3

Please indicate well location X.

ADDITIONAL INFORMATION

A series of 20 horizontal lines for writing additional information.

If more than one screen, show locations of each on sketch.