

NETON  
B 2007  
7-29-77

MISSISSIPPI  
 BOARD OF WATER COMMISSIONERS  
 416 North State Street  
 Jackson, Mississippi 39201

WATER WELL DRILLERS LOG

7-29-77  
 date well completed

13T McDonald & Hill  
 firm name


Newton  
 county well located

LANDOWNER:	description of formations encountered	from	to
<u>James Nelson</u>	<u>clay &amp; sand</u>	<u>0</u>	<u>47</u>
<u>Rt #1 Decatur</u> (mailing address)	<u>shale &amp; rock</u>	<u>47</u>	<u>60</u>
WELL LOCATION:	<u>sandy shale</u>	<u>60</u>	<u>70</u>
sec. <u>29</u> T. <u>8</u> N. R. <u>11</u> E	<u>sand &amp; shells</u>	<u>70</u>	<u>100</u>
<u>8</u> miles <u>NW</u> of <u>Decatur</u> (distance) (direction) (nearest town)	<u>sandy shale</u>	<u>100</u>	<u>125</u>
WELL PURPOSE:	<u>sand &amp; shells</u>	<u>125</u>	<u>150</u>
(home, irrigation, municipal, industrial)	<u>shale &amp; sand</u>	<u>150</u>	<u>210</u>
WELL COMPLETION DATA:	<u>sand</u>	<u>210</u>	<u>240</u>
(1) diameter (inches) <u>4"</u>	<u>Brown shale</u>	<u>210</u>	<u>250</u>
(2) total depth (feet) <u>270'</u>	<u>sand</u>	<u>250</u>	<u>270</u>
(3) static water level (feet) <u>225'</u> below top of ground.	<u>sandy shale</u>	<u>270</u>	<u>310</u>
(4) casing <u>PVC</u> , <u>320'</u> (material) (depth)	<u>shale</u>	<u>310</u>	<u>350</u>
<u>4"</u> if telescope see back. (size)	<u>Rock &amp; shell</u>	<u>350</u>	<u>370</u>
(5) screen <u>—</u> , <u>—</u> (length) (depth to top)	<u>open sand &amp; sandy shale</u>	<u>370</u>	<u>420</u>
(size) (material)			
(6) pump <u>30</u> , <u>69gpm</u> (HP) (yield gpm)			
<u>E</u> (type power)			
(7) electric log <u>—</u> (yes or no)			
(organization running log)			
(8) how well bottom plugged <u>Open</u>			
DRILLERS REMARKS:			

**RECEIVED**  
 AUG 4 1977

If well telescopes please sketch and show depths.

GROUND LEVEL

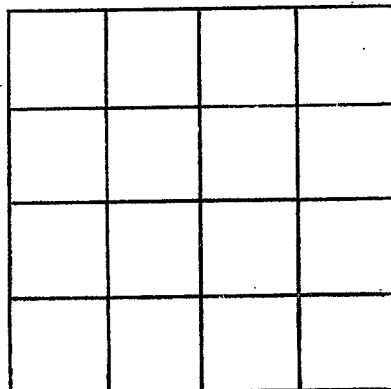

SECTION \_\_\_\_\_

Please indicate well location X.

ADDITIONAL INFORMATION

Lined area for additional information.

If more than one screen, show locations of each on sketch.