

NEWTON
B 2008
8-17-77

MISSISSIPPI
 BOARD OF WATER COMMISSIONERS
 416 North State Street
 Jackson, Mississippi 39201

WATER WELL DRILLERS LOG


8-17-77 ^{13T} McDonald's well Newton
 date well completed firm name county well located

LANDOWNER:	description of formations encountered	from	to
<u>Conrad Germany</u> <u>Union</u> (mailing address)			
	<u>shale</u>	<u>40</u>	<u>80</u>
WELL LOCATION:	<u>rock & shells</u>	<u>80</u>	<u>105</u>
sec. <u>4</u> T. <u>8</u> S. R. <u>11</u> E	<u>green sand</u>	<u>105</u>	<u>110</u>
<u>2 1/2</u> miles <u>WNW</u> of <u>Union</u>	<u>rock & shale</u>	<u>110</u>	<u>115</u>
(distance) (direction) (nearest town)	<u>course sand</u>	<u>115</u>	<u>130</u>
WELL PURPOSE: <u>name</u> (home, irrigation, municipal, industrial)			
WELL COMPLETION DATA:			
(1) diameter (inches) <u>2"</u>			
(2) total depth (feet) <u>130'</u>			
(3) static water level (feet) <u>37'</u> below above top of ground.			
(4) casing <u>PVC</u> , <u>125</u> (material) (depth)			
<u>2</u> if telescope see back. (size)			
(5) screen <u>5'</u> , <u>125 to 130</u> (length) (depth to top)			
<u>2</u> , <u>PVC</u> (size) (material)			
(6) pump <u>1/2</u> , <u>4000</u> (HP) (yield gpm)			
<u>R</u> (type power)			
(7) electric log <u>-</u> (yes or no)			
(organization running log)			
(8) how well bottom plugged <u>value</u>			
DRILLERS REMARKS:			

RECEIVED
 AUG 22 1977

If well telescopes please
sketch and show depths.

GROUND LEVEL

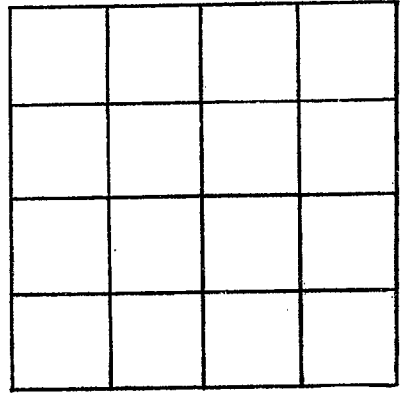

SECTION _____

Please indicate well location X.

ADDITIONAL INFORMATION

If more than one screen,
show locations of each on sketch.