

NEWTON

B 2012

MISSISSIPPI BOARD OF WATER COMMISSIONERS
416 North State Street
Jackson, Mississippi 39201

WATER WELL DRILLERS LOG

8-2-78
date well completed

McDonald & Hill
firm name

Newton
county well located

LANDOWNER:	description of formations encountered	from	to
M. R. Russell	clay & sand	0	23
Pt #1, Decatur, miss (mailing address)	shale	23	30
WELL LOCATION: sec. 34 T 8 N R 11 E 8 miles NW of Decatur (distance) (direction) (nearest town)	sand	30	47
WELL PURPOSE: home (home, irrigation, municipal, industrial)			
WELL COMPLETION DATA:			
(1) diameter (inches) 4"			
(2) total depth (feet) 47'			
(3) static water level (feet) 10' below top of ground.			
(4) casing PVC 42' (material) (depth) 4" (size) if telescope see back.			
(5) screen 5' 42' to 47' (length) (depth to top) 4" (size) PVC (material)			
(6) pump 7 (HP) 1000 gpm (yield) (gpm) E (type power)			
(7) electric log (yes or no)			
(organization running log)			
(8) how well bottom plugged valve			
DRILLERS REMARKS:			


RECEIVED

AUG - 7 1978

MISS. BD. OF WATER COMM

If well telescopes please sketch and show depths.

GROUND LEVEL

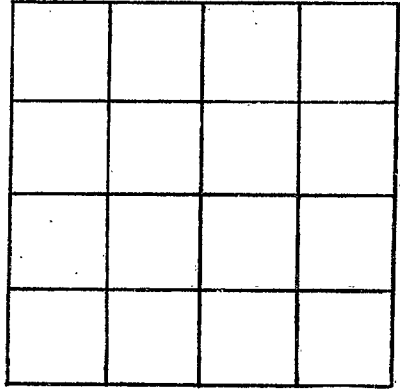

SECTION _____

Please indicate well location X.

ADDITIONAL INFORMATION

If more than one screen,
show locations of each on sketch.