

NEWTON
B 203
11-2-78

MISSISSIPPI  
 BOARD OF WATER COMMISSIONERS  
 416 North State Street  
 Jackson, Mississippi 39201

WATER WELL DRILLERS LOG

11-2-78 19 McDonald & Hill Newton  
 date well completed firm name county well located


LANDOWNER:	description of formations encountered	from	to
<u>Rouse Milling</u>	<u>Clay &amp; sand</u>	<u>0</u>	<u>20</u>
<u>Rt 1 Decatur</u> (mailing address)	<u>sand</u>	<u>20</u>	<u>50</u>
WELL LOCATION:	<u>sand &amp; sh. shale &amp; lignite</u>	<u>50</u>	<u>125</u>
sec. <u>31</u> T. <u>9</u> N. R. <u>11</u> E	<u>sandy shale</u>	<u>125</u>	<u>165</u>
<u>4</u> miles <u>N.E.</u> of <u>Concha</u>	<u>shale</u>	<u>165</u>	<u>202</u>
(distance) (direction) (nearest town)	<u>rocks &amp; shells</u>	<u>202</u>	<u>225</u>
WELL PURPOSE: <u>none</u> (home, irrigation, municipal, industrial)	<u>green sand &amp; sandy shale</u>	<u>225</u>	<u>240</u>
WELL COMPLETION DATA:	<u>rocks &amp; shale</u>	<u>240</u>	<u>270</u>
(1) diameter (inches) <u>4"</u>	<u>white sand</u>	<u>270</u>	<u>280</u>
(2) total depth (feet) <u>280'</u>			
(3) static water level (feet) <u>80'</u> below top of ground.			
(4) casing <u>PVC</u> <u>190'</u> (material) (depth)			
<u>4"</u> (size) If telescope see back.			
(5) screen _____ (length) (depth to top)			
(size) (material)			
(6) pump <u>1/2</u> <u>69.0PM</u> (HP) (yld/gpm)			
<u>F</u> (type power)			
(7) electric log _____ (yes or no)			
(organization running log)			
(8) how well bottom plugged <u>open</u>			
DRILLERS REMARKS:			

RECEIVED  
 NOV 6 1978

MISS. BD. OF WATER COMM.

If well telescopes please sketch and show depths.

GROUND LEVEL

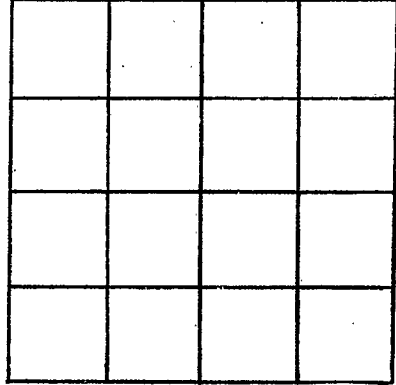

SECTION \_\_\_\_\_

Please indicate well location X.

ADDITIONAL INFORMATION

If more than one screen, show locations of each on sketch.