

Newton  
B 2014  
5-29-79

MISSISSIPPI  
 BOARD OF WATER COMMISSIONERS  
 416 North State Street  
 Jackson, Mississippi 39201

WATER WELL DRILLERS LOG

5-29-79 19 McDonald & Hill Newton  
 date well completed firm name county well located

LANDOWNER:	description of formations encountered	from	to
<u>Elizabeth Isaac</u>	<u>clay &amp; sand</u>	<u>0</u>	<u>25</u>
<u>Conhatta</u> (mailing address)	<u>sandy shale</u>	<u>25</u>	<u>70</u>
WELL LOCATION: sec. <u>31</u> T. <u>20</u> N. R. <u>10</u> E <u>4</u> miles <u>NE</u> of <u>Conhatta</u> (distance) (direction) (nearest town)	<u>sand &amp; shale</u>	<u>70</u>	<u>200</u>
WELL PURPOSE: <u>home</u> (home, irrigation, municipal, industrial)	<u>sandy shale</u>	<u>200</u>	<u>245</u>
WELL COMPLETION DATA: (1) diameter (inches) <u>4"</u>	<u>shale</u>	<u>245</u>	<u>285</u>
(2) total depth (feet) <u>340</u>	<u>Rock &amp; shells</u>	<u>285</u>	<u>312</u>
(3) static water level (feet) <u>155'</u> below above top of ground.	<u>greensand &amp; sandy shale</u>	<u>312</u>	<u>330</u>
(4) casing <u>PVC</u> , <u>260'</u> (material) (depth)	<u>Rock &amp; shale &amp; sand</u>	<u>330</u>	<u>340</u>
<u>4"</u> (size) If telescope see back.			
(5) screen _____ (length) (depth to top)			
(size) (material)			
(6) pump <u>34</u> <u>6 gpm</u> (HP) (yield gpm)			
<u>E</u> (type power)			
(7) electric log _____ (yes or no)			
(organization running log)			
(8) how well bottom plugged <u>open</u>			
DRILLERS REMARKS:			


Miss. Board of Water Comm.

JUN - 6 1979

RECEIVED

If well telescopes please sketch and show depths.

GROUND LEVEL

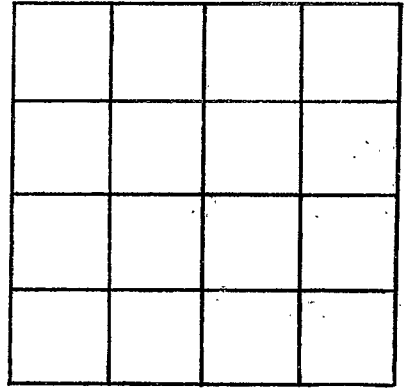

SECTION \_\_\_\_\_

Please indicate well location X.

ADDITIONAL INFORMATION

If more than one screen,  
show locations of each on sketch.