

NEWTON
B 2015
6-13-79

**MISSISSIPPI
 BOARD OF WATER COMMISSIONERS**
 416 North State Street
 Jackson, Mississippi 39201

WATER WELL DRILLERS LOG

6-13-79 19 McDonald & Mill Newton
 date well completed firm name county well located

LANDOWNER:	description of formations encountered	from	to
<u>Jimmy Mulling</u> <u>Rt # 2 Union</u> (mailing address)	<u>clay & sand</u>	<u>0</u>	<u>25</u>
	<u>Sand</u>	<u>25</u>	<u>50</u>
WELL LOCATION:	<u>shale & lignite</u>	<u>50</u>	<u>90</u>
sec. <u>29</u> T. <u>8</u> N. R. <u>11</u> E	<u>sand & shale</u>	<u>90</u>	<u>135</u>
<u>6</u> miles <u>NW</u> of <u>Stratton</u>	<u>sandy shale</u>	<u>135</u>	<u>175</u>
(distance) (direction) (nearest town)	<u>shale</u>	<u>175</u>	<u>205</u>
WELL PURPOSE: <u>home</u> (home, irrigation, municipal, industrial)	<u>Rock & shells</u>	<u>205</u>	<u>225</u>
WELL COMPLETION DATA:	<u>green sand & sandy shale</u>	<u>225</u>	<u>240</u>
(1) diameter (inches) <u>4"</u>			
(2) total depth (feet) <u>240'</u>			
(3) static water level (feet) <u>100'</u> below above top of ground.			
(4) casing <u>PVC</u> , <u>190'</u> (material) (depth)			
<u>4"</u> (size) If telescope see back.			
(5) screen _____ (length) (depth to top)			
_____ (size) _____ (material)			
(6) pump <u>3/4</u> <u>8000</u> (HP) (field gpm)			
<u>F</u> (type power)			
(7) electric log _____ (yes or no)			
_____ (organization running log)			
(8) how well bottom plugged <u>open</u>			
DRILLERS REMARKS:			


Miss. Board of Water Comm.

JUN 18 1979

RECEIVED

If well telescopes please sketch and show depths.

GROUND LEVEL

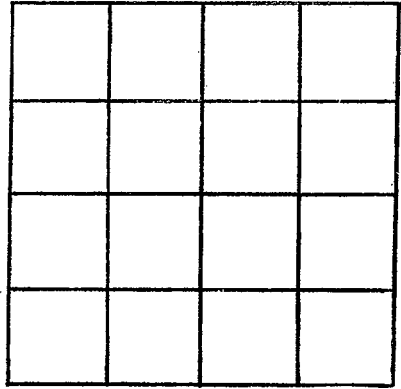

SECTION _____

Please indicate well location X.

ADDITIONAL INFORMATION

If more than one screen,
show locations of each on sketch.