

Newton
B 208
1-8-80

MISSISSIPPI
BOARD OF WATER COMMISSIONERS
416 North State Street
Jackson, Mississippi 39201

WATER WELL DRILLERS LOG


1-8-80 19 McDonald & Hill Newton
date well completed firm name county well located

LANDOWNER:	description of formations encountered	from	to
Mrs. Alma Wallace	clay & sand	0	20
Rt # 2 Union (mailing address)	shale & sand	20	50
WELL LOCATION: sec. 30 T. 8 N. R. 11 E 10 miles NW of Decatur (distance) (direction) (nearest town)	sand	50	105
WELL PURPOSE: <u>home</u> (home, irrigation, municipal, industrial)	sandy shale	105	140
WELL COMPLETION DATA: (1) diameter (inches) <u>4"</u>	shale	140	172
(2) total depth (feet) <u>220'</u>	Rock & shells	172	190
(3) static water level (feet) <u>80'</u> below top of ground.	open sand & sandy shale	190	205
(4) casing <u>PVC 160'</u> (material) (depth)	Rock shale & sand	205	220
<u>4"</u> if telescope see back. (size)			
(5) screen _____ (length) (depth to top)			
(size) (material)			
(6) pump <u>1/2</u> <u>89 gpm</u> (HP) (std gpm)			
<u>F</u> (type power)			
(7) electric log _____ (yes or no)			
(organization running log)			
(8) how well bottom plugged <u>Open</u>			
DRILLERS REMARKS:			

DEPT. OF NATURAL RESOURCES
BUREAU OF LAND & WATER RESOURCES
JAN 16 1980
RECEIVED

If well telescopes please sketch and show depths.

GROUND LEVEL

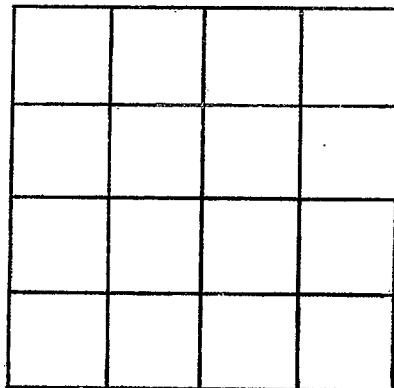

SECTION _____

Please indicate well location X.

ADDITIONAL INFORMATION

If more than one screen,
show locations of each on sketch.