

Newton
B 219
12/11/80

MISSISSIPPI
BOARD OF WATER COMMISSIONERS
416 North State Street
Jackson, Mississippi 39201

WATER WELL DRILLERS LOG

12-11-80 date well completed
McDonald Hill firm name
NEWTON county well located

LANDOWNER:	description of formations encountered	from	to
Delbert Graham	clay & sand	0	50
Union Miss (mailing address)	sandy shale	50	60
WELL LOCATION:	shale	60	102
sec. 6 T ² N R 11 E S W	rock shells	102	140
10 miles W of Union (distance) (direction) (nearest town)	green sand	140	150
WELL PURPOSE: home (home, irrigation, municipal, industrial)	sandy shale	150	160
WELL COMPLETION DATA:			
(1) diameter (inches) 4"			
(2) total depth (feet) 180			
(3) static water level (feet) 42' below top of ground.			
(4) casing PVC 98' (material) (depth) 4" (size) if telescope see back.			
(5) screen (length) (depth to top) (size) (material)			
(6) pump 1/2 89 gpm (HP) (yield gpm) F (type power)			
(7) electric log (yes or no) (organization running log)			
(8) how well bottom plugged Open			

DEPT. OF NATURAL RESOURCES
BUREAU OF LAND & WATER RESOURCES


DEC 15 1980

RECEIVED

DRILLERS REMARKS: Go to center - Go out 492 feet - meat market - take 1st B-top to right - 5th house on left - chicken house

If well telescopes please sketch and show depths.

GROUND LEVEL

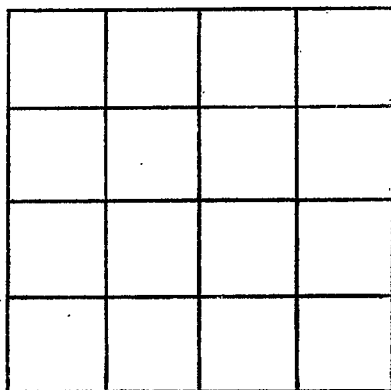

SECTION _____

Please indicate well location X.

ADDITIONAL INFORMATION

If more than one screen, show locations of each on sketch.