

Newton
B 2021
2/19/81

MISSISSIPPI
 BOARD OF WATER COMMISSIONERS
 416 North State Street
 Jackson, Mississippi 39201

WATER WELL DRILLERS LOG

12-19 1981 Thompson & Son Newton
 date well completed firm name county well located


LANDOWNER: Robert Thompson
Rt 2
Union, Ms.
 (mailing address)

description of formations encountered	from to	
<u>Red Clay</u>	<u>0</u>	<u>8</u>
<u>SAND</u>	<u>8</u>	<u>43</u>
<u>Lig Nitid + Grey CLAY</u>	<u>43</u>	<u>56</u>
<u>SAND w/STKS CHALK</u>	<u>56</u>	<u>90</u>
<u>FINE SAND w/CHALK</u>	<u>90</u>	<u>110</u>

WELL LOCATION:
 sec. 17 T S N 4 R 4 E W
4 1/2 miles SW of Union
 (distance) (direction) (nearest town)

WELL PURPOSE: FISH POND
 (home, irrigation, municipal, industrial)

- WELL COMPLETION DATA:
- (1) diameter (inches) 4
 - (2) total depth (feet) 110
 - (3) static water level (feet) 40 below top of ground.
 - (4) casing PVC, 80
 (material) (depth)
4 if telescope see back.
 (size)
 - (5) screen 30, 80
 (length) (depth to top)
2", PVC
 (size) (material)
 - (6) pump 1/2, 12
 (HP) (yield gpm)
Elec
 (type power)
 - (7) electric log no
 (yes or no)
 - (organization running log)
 - (8) how well bottom plugged POINT

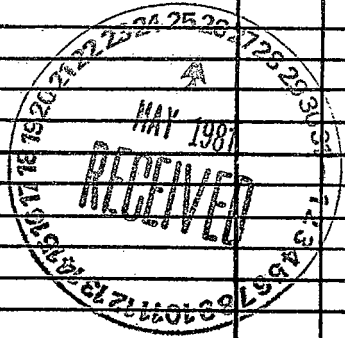

DRILLERS REMARKS:

