

Newton
B
2023

MISSISSIPPI
BOARD OF WATER COMMISSIONERS
416 North State Street
Jackson, Mississippi 39201

WATER WELL DRILLERS LOG

date well completed 19 81 McDonald Hilltop firm name Newton county well located

LANDOWNER: Joe Fop
P.O. Box 425
Orcutt, Miss
(mailing address)

WELL LOCATION:
sec. 23 T. 4 N. R. 11 E
6 miles north of Orcutt
(distance) (direction) (nearest town)

WELL PURPOSE: none
(home, irrigation, municipal, industrial)

WELL COMPLETION DATA:

(1) diameter (inches) 4

(2) total depth (feet) 140

(3) static water level (feet) 77 below above top of ground.

(4) casing 4" Pvc 81'
(material) (depth)
(size) if telescope see back.

(5) screen 5 135
(length) (depth to top)
(size) (material)

(6) pump 1 10
(HP) (yield gpm)
(type power)

(7) electric log yes
(yes or no)
(organization running log)

(8) how well bottom plugged _____


description of formations encountered	from	to
Clay & sand	0	50
shaly sandst	50	65
shale	65	90
Sandy st Rock	90	105
st green sand	105	125
fine sand	125	140

DEPT. OF NATURAL RESOURCES
BUREAU OF LAND & WATER RESOURCES
JAN 12 1982
RECEIVED

DRILLERS REMARKS: set pump 120'

If well telescopes please sketch and show depths.

GROUND LEVEL

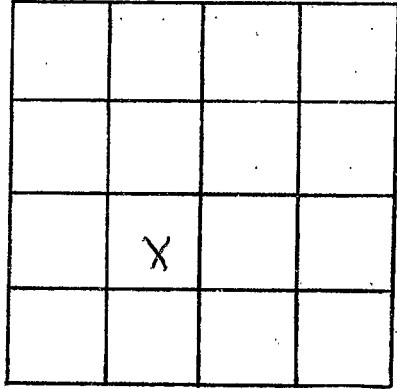

SECTION 23

Please indicate well location X.

ADDITIONAL INFORMATION

Lined area for additional information.

If more than one screen, show locations of each on sketch.