

Newton
B
2024

MISSISSIPPI
 BOARD OF WATER COMMISSIONERS
 416 North State Street
 Jackson, Mississippi 39201
 WATER WELL DRILLERS LOG

5-18 1982 COMANS DRILLING SER. Newton
 date well completed firm name county well located

LANDOWNER: Douglas VANCE.
Rte # 2
Union, Miss.
 (mailing address)

WELL LOCATION:
 sec. 6 T. 8 N. R. 14 E
S W
Six miles West of UNION.
 (distance) (direction) (nearest town)

WELL PURPOSE: Home
 (home, irrigation, municipal, industrial)

- WELL COMPLETION DATA:
- (1) diameter (inches) 2
 - (2) total depth (feet) 60
 - (3) static water level (feet) 35 below above top of ground.
 - (4) casing pvc, 55'
 (material) (depth)
2" if telescope see back.
 (size)
 - (5) screen 5', 55'
 (length) (depth to top)
1/4", stainless steel
 (size) (material)
 - (6) pump 1
 (HP) (yield gpm)
 (type power)
 - (7) electric log _____
 (yes or no)
 (organization running log)
 - (8) how well bottom plugged _____


description of formations encountered	from	to
<u>SANDY CLAY</u>	<u>0</u>	<u>18</u>
<u>CLAY AND ROCKY DARK CLAY</u>	<u>18</u>	<u>22</u>
<u>FINE SAND</u>	<u>22</u>	<u>26</u>
<u>BROWN CLAY</u>	<u>26</u>	<u>30</u>
<u>VERY HARD CLAY</u>	<u>30</u>	<u>37</u>
<u>SAND LEDGES</u>	<u>37</u>	<u>39</u>
<u>SAND AT</u>	<u>42</u>	
<u>SAND + LIGNITE</u>	<u>42</u>	<u>46</u>
<u>SAND</u>	<u>46</u>	<u>65</u>

DRILLERS REMARKS:

DEPT OF NATURAL RESOURCES
 BUREAU OF LAND & WATER RESOURCES
 JUL - 7 1982
 RECEIVED

If well telescopes please sketch and show depths.

GROUND LEVEL

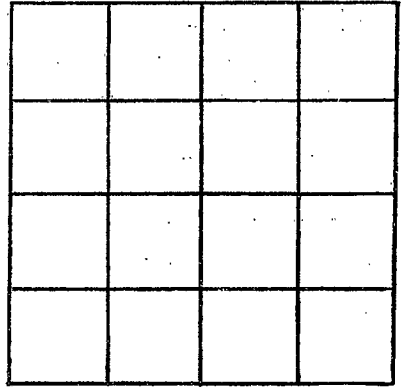

SECTION _____

Please indicate well location X.

ADDITIONAL INFORMATION

If more than one screen,
show locations of each on sketch.