

Newton
B
225

MISSISSIPPI DEPARTMENT OF NATURAL RESOURCES
 Bureau of Land and Water Resources
 Southport Mall
 P.O. Box 10631
 Jackson, Mississippi 39209
WATER WELL DRILLERS LOG


3- 1985 McDonald & Hillman Newton
 date well completed firm name county well located

LANDOWNER: <u>Billy Taylor</u>	description of formations encountered	from	to
	<u>sand</u>	<u>0</u>	<u>75</u>
(mailing address)			
WELL LOCATION:			
sec. <u>13</u> T. <u>8</u> S. R. <u>11</u> E.			
<u>7</u> miles <u>North</u> of <u>Decatur</u>			
(distance) (direction) (nearest town)			
WELL PURPOSE: <u>home</u>			
(home, irrigation, municipal, industrial)			
WELL COMPLETION DATA:			
(1) diameter (inches) <u>2" ⌀</u>			
(2) total depth (feet) <u>75'</u>			
(3) static water level (feet) <u>21</u> below above top of ground.			
(4) casing <u>2" PVC 65'</u>			
(material) (depth)			
(size) if telescope see back.			
(5) screen <u>10' #12 65'</u>			
(length) (depth to top)			
<u>2" 2" PVC</u>			
(size) (material)			
(6) pump <u>10</u>			
(HP) (yield gpm)			
(type power)			
(7) electric log <u> </u>			
(yes or no)			
(organization running log)			
(8) how well bottom plugged <u>2" pack</u>			
<u>pressure valve</u>			
DRILLERS REMARKS:			

RECEIVED
 MAR 8 - 1985
 Department of Natural Resources
 Bureau of Land & Water Resources

If well telescopes please
sketch and show depths.

GROUND LEVEL

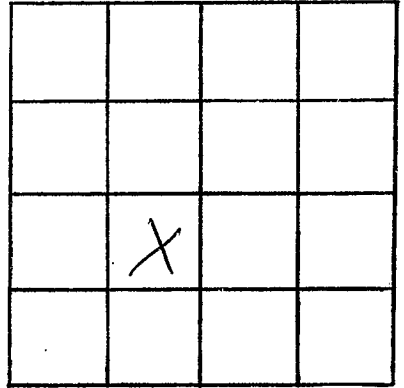

SECTION 23

Please indicate well location X.

ADDITIONAL INFORMATION

If more than one screen,
show locations of each on sketch.