

MISSISSIPPI DEPARTMENT OF NATURAL RESOURCES

Bureau of Land and Water Resources

Southport Mall

P.O. Box 10631

Jackson, Mississippi 39209

WATER WELL DRILLERS LOG

Newton
B 2026

1-21-86 19 McDONALD + HILL firm name NEWTON county well located
 date well completed

LANDOWNER: <u>ROBERT REID</u>	description of formations encountered	from	to
<u>R#1 Box 242</u>			
<u>DECATUR MS</u> (mailing address)	<u>SILT</u>	<u>20</u>	<u>25</u>
	<u>SAND</u>	<u>30</u>	<u>86</u>

WELL LOCATION:
 sec. 34 8 N R. 11 E
 S W
4 miles N.W. of DECATUR
 (distance) (direction) (nearest town)

WELL PURPOSE: HOME
 (home, irrigation, municipal, industrial)

WELL COMPLETION DATA:

(1) diameter (inches) 2"

(2) total depth (feet) 86'

(3) static water level (feet) 46' below above top of ground.


(4) casing PVC, 76'
 (material) (depth)
2" If telescope see back.
 (size)

(5) screen 10, 76'
 (length) (depth to top)
2", PVC
 (size) (material)

(6) pump _____ (HP) _____ (yield gpm)
 (type power)

(7) electric log _____ (yes or no)
 _____ (organization running log)

(8) how well bottom plugged VALVE

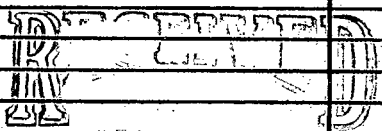


FEB -7 1986

Department of Natural Resources
 Bureau of Land & Water Resources

DRILLERS REMARKS:
SET JET 74'

If well telescopes please sketch and show depths.

GROUND LEVEL

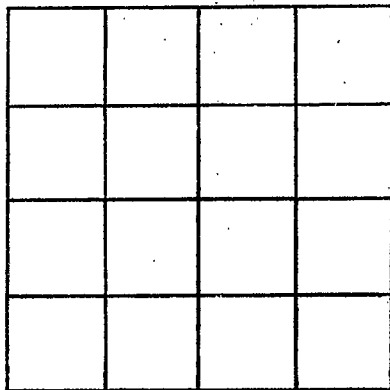

SECTION _____

Please indicate well location X.

ADDITIONAL INFORMATION

If more than one screen,
show locations of each on sketch.