

MISSISSIPPI DEPARTMENT OF NATURAL RESOURCES

Bureau of Land and Water Resources

COUNTY, WELL LOCATED NEWTON	
WELL NUMBER B 2028	CODED
DATE WELL COMPLETED 9-28-87	

PERMIT NUMBER 0-474
NAME OF DRILLING FIRM GARDNER DRILLING SERVICE

P.O. Box 10631
Jackson, Mississippi 39209
WATER WELL DRILLERS LOG

NAME & MAILING ADDRESS OF LANDOWNER ELIZABETH LUNDY RT. 2 BOX 150 UNION, MS. 39365			
WELL LOCATION:	SEC	TOWNSHIP	RANGE
	26	8 N S	11 E W
DISTANCE	DIRECTION	NEAREST TOWN	
5 Miles	SW	of UNION	
OTHER LANDMARK			
WELL PURPOSE: Home, Irrigation, Municipal, Industrial, Fish Pond, etc. HOME			

PUMP DATA		
PUMP TYPE (Circle One): Submersible, Turbine, <u>Jet</u> Flowing Well, Other (Describe) _____		
POWER TYPE (Circle One): Electric, Tractor, Diesel, Gasoline, Butane, Other (Describe) _____		
Pump Capacity (GPM) 6	No. of Stages 2	Setting Depth 50 FT.
PUMP TEST Well yielded 6 GPM with a drawdown of 5 ft. after 1 hours of pumping		

WELL DATA		
Well Depth 150'	Casing Diameter (In.) 2"	Casing Length (Ft.) 100'
Type of Casing PVC	Hole Depth 150	Depth to Static Water Level 30 FT
TYPE OF COMPLETION: (Circle One or More): Gravel Packed, Underreamed, Telescoped, Natural Development, <u>Open Hole</u> , Other (Describe) _____		
Top of Lap Pipe or Reduction in Casing		
FEET	IF TELESCOPED OR MORE THAN ONE SCREEN: USE BACK PAGE	

LOG DATA		
TYPE OF LOG RUN (Circle One): Electric, Gamma Ray, Density, Sonic, <u>No Log Run</u> , Other (Describe) _____		
Name of Organization Running Log _____		

SCREEN DATA		
Diameter - Inches _____	Length - Feet _____	Slot Size - Inches _____
Screen Type _____	Depth to Bottom - Feet _____	

GEOLOGIC DATA (Office Use Only)			
Surface Elev.	Geologic Unit	Unit Thickness	Depth to Top
Subs. SWL	Date	Analysis	Aquifer Test
Driller's Remarks			

DESCRIPTION OF FORMATIONS ENCOUNTERED	FROM	TO	FORMATIONS (continued)	FROM	TO
CLAY	0	10			
SAND	10	22			
CLAY	22	40			
SAND	40	75			
ROCK	75	80			
SHELL	80	100			
ROCK	100	102			
SAND	102	150			

RECEIVED


JUN 16 1988

Department of Natural Resources
Bureau of Land & Water Resources

IF MORE SPACE IS NEEDED, USE BACK

If well telescopes please sketch and show depths.

GROUND LEVEL

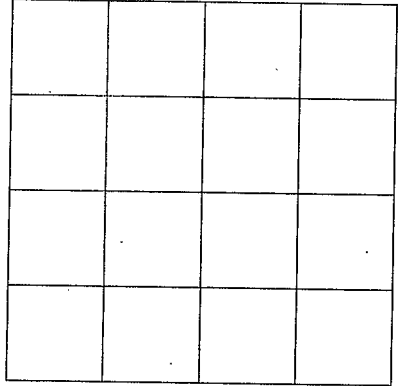

SECTION _____

Please indicate well location X.

ADDITIONAL INFORMATION

A series of horizontal lines for writing additional information, starting below the 'ADDITIONAL INFORMATION' header and extending to the bottom of the page.

If more than one screen, show location of each on sketch.