

NEWTON

C 3

9-1-60

WATER WELL DRILLERS LOG

Bole

Forest Drilling

Date: 9/1, 1960, Driller: James McGee County Newton

(Name)

(1) Owner of Land: William H. Davis
(Name)
Rt. 3, Decatur, Miss.
(Address)

(2) Location: $\frac{1}{4}$, $\frac{1}{4}$, Sec. 16 T. 8 N. R. 12 W.
9 miles North of Decatur,
(distance) (direction) (Nearest Town)

(3) Topography: X
(Hilly) (Flat) (Level)

(4) Purpose of Well: Domestic
(Domestic Irrigation
Municipal, Industrial, Other)

Description & Color of Materials Sand, Clay, Red Clay, Shell, etc.	Thick- ness Feet	Depth Feet
Brown clay.	0	12
Red sand & Clay.	12	22
Sand & Stks. clay.	22	32
Sand. (Screen set)	32	42
Clay.	42	52
Clay & Stks. rock.	52	72
Clay.	72	112

Information upon completion of well:

(1) Diameter 2 inches.

(2) Total Depth 42 feet.

(3) Water Level 23 feet below top of ground.

(4) Cased to 37', Size 2"


(5) Screen: Size 2", Length 5'

(6) Were any formations sealed against pollution?
X yes, X no.

If YES depth of formation _____

Why _____

Drillers Remarks: XXXX Good well.

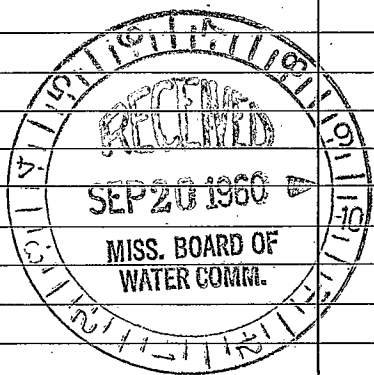

Well No.

(Use Back Side)

...

...

