

6 NEWTON
C7

WATER WELL DRILLERS LOG

Mc Donald & Well newton

Date: 7-2-63 1963, Driller: JAMES M. TROCK County: Newton

(Name)

(1) Owner of Land: JACK BISHOP
(Name)
LITTLE ROCK MISS
(Address)

(2) Location: 1/4, 1/4, Sec. 24 T8N R12E
miles, of
(distance) (direction) (Nearest Town)

(3) Topography: X
(Hilly) (Flat) (Level)

(4) Purpose of Well: DOMESTIC
(Domestic Irrigation
Municipal, Industrial, Other)

Description & Color of Materials Sand, Clay, Red Clay, Shell, etc.	Thick- ness Feet	Depth Feet
CLAY	0	20
SAND	20	32
ROCK	32	140
SAND	140	164
SHALE ST SAND	164	302
SAND	302	310

Information upon completion of well:

(1) Diameter: 3 1/2 inches. HOLE

(2) Total Depth: 310' feet.


(3) Water Level: 148' feet below top of ground.

(4) Cased to: 302', Size 2"

(5) Screen: Size 2", Length 4'

(6) Were any formations sealed against pollution?
_____ yes, _____ no.

If YES depth of formation _____
Why _____
Drillers Remarks: _____

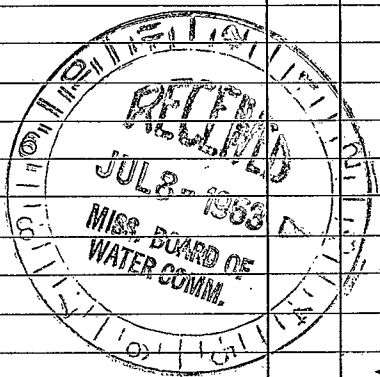

(Use Back Side)

Well No.

