

6 NEWTON
C9

MISSISSIPPI BOARD OF WATER COMMISSIONERS

3-1-65

WATER WELL DRILLERS LOG

newton

Date: 3/1/65, 1965, Driller: McDONALD & Hill County Lauderdale

(Name)

(1) Owner of Land: James C. Deann
(Name)

RT # 2 Little Rock, Miss.
(Address)

(2) Location: 1/4, 1/4, Sec. 4 1/4 1/4
5 miles NW of Little Rock
(distance) (direction) (Nearest Town)

(3) Topography: (Hilly) (Flat) (Level)

(4) Purpose of Well: Domestic
(Domestic Irrigation, Municipal, Industrial, Other)

Description & Color of Materials Sand, Clay, Red Clay, Shell, etc.	Thick- ness Feet	Depth Feet
Clay	8	10
Red Sand	10	30
Clay	30	32
white sand	32	36
yellow clay	36	40
Hard shell rock	40	112
Soft shale	112	115
Soft shale	115	130
C sand	130	145
lig. & fine sand	145	185
soft shale thin sand	185	215
H shale	215	230
C sand	230	235
Soft shale	235	240
C sand & shale str.	240	250
M sand	250	260

Information upon completion of well:

(1) Diameter 4 inches.

(2) Total Depth 260 feet.

(3) Water Level 165 feet below top of ground.


(4) Cased to 216, Size 4"

(5) Screen: Size _____, Length _____

(6) Were any formations sealed against pollution?
 yes, no.

If YES depth of formation _____
Why _____

Drillers Remarks: _____

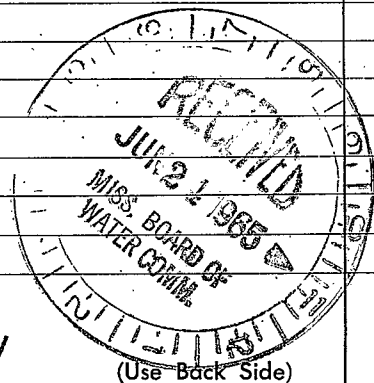

Well No.

