

3 Newton
C12

12-66

MISSISSIPPI BOARD OF WATER COMMISSIONERS

WATER WELL DRILLERS LOG

Date: 12-2, 1966, Driller: M E Donald & Hill County Newton
(When well drilled) (Name) (Where well is located)

(1) Owner of Land: MRS HAZEL PINSON
(Name)

LITTLE ROCK MISS
(Address)

(2) Location: NE 1/4, SW 1/4, Sec. 13 T8 R12, N E
3 miles WEST of LITTLE ROCK
(distance) (direction) (Nearest Town)

(3) Topography: X
(Hilly) (Flat) (Level)

(4) Purpose of Well: DOMESTIC
(Domestic Irrigation
Municipal, Industrial, Other)

Description & Color of Materials Sand, Clay, Red Clay, Shell, etc.	Thick- ness. Feet	Depth Feet
Clay	18	18
Sand Clay	10	28
Clay	5	33
Sand	11	44
Shale & Rock	108	152
Sand	33	185
Sand	25	210

Information upon completion of well:

(1) Diameter: 4 x 2 WELL inches.

(2) Total Depth: 210' feet.

(3) Water Level: 125' feet below top of ground.

(4) Cased to: 201', Size: 2" GALV
46' 4" BLACK

(5) Screen: Size: 2", Length: 5'

(6) Were any formations sealed against pollution?

yes, X no.

If YES depth of formation


Why

Drillers Remarks:

Yield in gpm: 30

Size pump:

Type power:

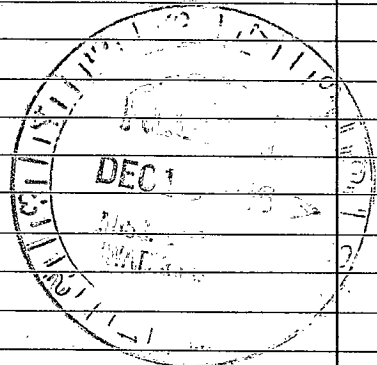

3

[The page contains extremely faint and illegible text, likely bleed-through from the reverse side of the document. The text is too light to transcribe accurately.]