

E 10921

GW-00943

CODED

Code

NEWTON
 C 15
 11-14-68
 Miss Geo Sumr

MISSISSIPPI
 BOARD OF WATER COMMISSIONERS
 416 North State Street
 Jackson, Mississippi 39201

CODED

WATER WELL DRILLERS LOG

11-14 1968 date well completed Rayne Central Co. firm name Newton county well located


LANDOWNER:
Baulch, Hubbard Water Assoc.
Little Rock, Miss.
 (mailing address)

description of fomations encountered	from	to
Clay	0	20
Brittle Clay	20	48
Exp. Struck Clay	48	85
Shale	85	159
Sandy Shale	159	202
Clay	202	249
Sandy Shale	249	476
Shale	476	522
Shale, S.S. Black-Tan Sand	522	922
Sand	922	968
Shale	968	974'

WELL LOCATION:
 sec 23 T 8 N R 12 E
 S W
1 1/2 miles West of Little Rock
 (distance) (direction) (nearest town)

WELL PURPOSE: Domestic
 (home, irrigation, municipal, industrial)

- WELL COMPLETION DATA:
- (1) diameter (inches) 8"
 - (2) total depth (feet) 974'
 - (3) static water level (feet) 205' below top of ground.
 - (4) casing Steel, 921',
 (material) (depth)
8" if telescope see back.
 (size)
 - (5) screen 44', 921'
 (length) (depth to top)
6", Stainless Steel
 (size) (material)
 - (6) pump 25 (HP) (yield gpm)
Electric
 (type power)
 - (7) electric log Yes
 (yes or no)
Miss. Geo. Surveys
 (organization running log)
 - (8) how well bottom plugged valve

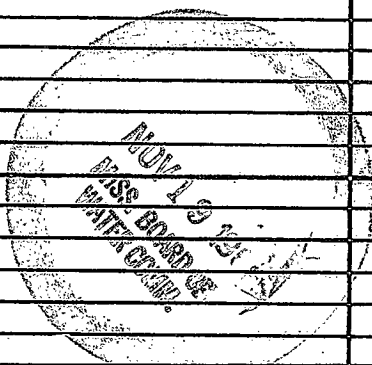


DRILLERS REMARKS:

Pump not installed
no test as of this date

1. 10.17
If well telescopes please sketch and show depths.

GROUND LEVEL

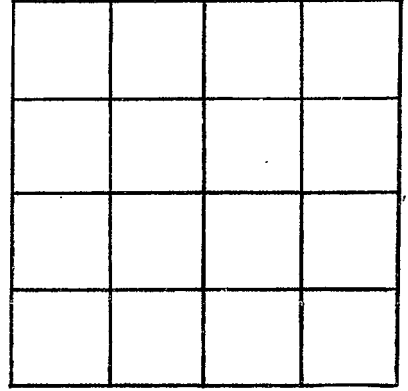

SECTION _____

Please indicate well location X.

ADDITIONAL INFORMATION

If more than one screen,
show locations of each on sketch.