

CODED

Coded

MISSISSIPPI
 BOARD OF WATER COMMISSIONERS
 416 North State Street
 Jackson, Mississippi 39201

CODED

WATER WELL DRILLERS LOG

Newton
 CT6
 12-4-68

Dec 4 1968 Mc Donald Hill Etc. Newton
 date well completed firm name county well located

LANDOWNER: James E. Thomas

description of formations encountered

from to

Rt 2

Clay + sand

0 35

Decatur Miss

SANDY

35 50

(mailing address)

Shell

50 85

WELL LOCATION:

limey shell + rock

85 108

sec. 30 T B N R 12 E S W

Coarse gravelly sand

108 122

6 miles NORTH of Decatur
(distance) (direction) (nearest town)

Rock + shell

122 160

ST. Coarse sand

160 180

Rock + shell

180 200

ST sand

200 210

WELL PURPOSE: Home
(home, irrigation, municipal, industrial)

WELL COMPLETION DATA:

(1) diameter (inches) 4
(2) total depth (feet) 210

(3) static water level (feet) 80 below above top of ground.

(4) casing 4" 63'
(material) (depth)

DEC - 3 1968

(size) if telescope see back.

(5) screen (length) (depth to top)

MISS. Bd. OF WATER COMMISSIONERS

(size) (material)

(6) pump 3/4 (HP) (yield gpm)

AET
(type power)

(7) electric log (yes or no)


(organization running log)

(8) how well bottom plugged

DRILLERS REMARKS:

If well telescopes please sketch and show depths.

GROUND LEVEL

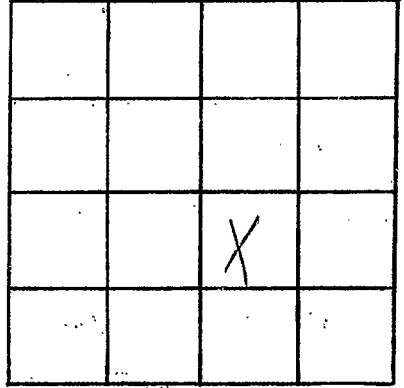

SECTION 30

Please indicate well location X.

ADDITIONAL INFORMATION

If more than one screen,
show locations of each on sketch.