

Newton
C18
7-5-69

MISSISSIPPI
 BOARD OF WATER COMMISSIONERS
 416 North State Street
 Jackson, Mississippi 39201

CODED

JUL 22 1969

MISS. BD. OF
 WATER COMM.


WATER WELL DRILLERS LOG

July 5 1969 McDonald Hill Inc. Newton
 date well completed firm name county well located

LANDOWNER: <u>Donald A. Good</u>	description of formations encountered	from	to
<u>Rt #1</u>		<u>Clay</u>	<u>0</u>
<u>Decatur Miss</u> (mailing address)	<u>ST ROCK SAND</u>	<u>10</u>	<u>50</u>
	<u>ST SAND SAND</u>	<u>50</u>	<u>145</u>
	<u>COARSE SAND</u>	<u>145</u>	<u>210</u>
	<u>ST SAND</u>	<u>210</u>	<u>253</u>
	<u>SHELL</u>	<u>253</u>	<u>300</u>
	<u>ST ROCK SAND</u>	<u>300</u>	<u>300</u>
WELL LOCATION: sec. <u>18</u> T. <u>8</u> N. R. <u>12</u> E. <u>6</u> miles <u>North</u> of <u>Decatur</u> (distance) (direction) (nearest town)			
WELL PURPOSE: <u>Home</u> (home, irrigation, municipal, industrial)			
WELL COMPLETION DATA:			
(1) diameter (inches) <u>4</u>			
(2) total depth (feet) <u>300</u>			
(3) static water level (feet) <u>155</u> below top of ground.			
(4) casing <u>4" Black</u> <u>273</u> (material) (depth)			
<u>no</u> if telescope see back. (size)			
(5) screen <u>no</u> (length) (depth to top)			
(size) (material)			
(6) pump <u>3/4</u> <u>10</u> (HP) (yield gpm)			
<u>meyers</u> <u>submersible</u> (type power)			
(7) electric log <u>no</u> (yes or no)			
<u>no</u> (organization running log)			
(8) how well bottom plugged <u>open</u> <u>well</u>			
DRILLERS REMARKS: <u>none</u>			

If well telescopes please sketch and show depths.

GROUND LEVEL

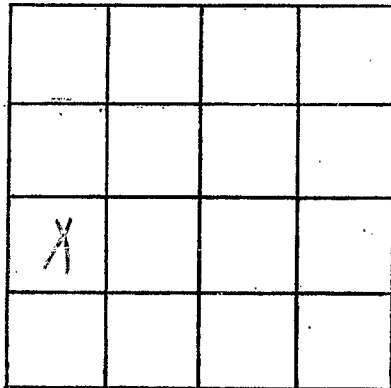

SECTION 18

Please indicate well location X.

ADDITIONAL INFORMATION

If more than one screen,
show locations of each on sketch.